Martsolf Architecture

January 15, 2024

Addendum #1 - Martsolf Architecture Project No. 2307

St Jude Catholic Church Parish Hall Remodel & Connector

Mansfield, Texas

This addendum modifies the Plans and Specifications dated December 20, 2023

General Notes:

1. Clarifying that the Fire sprinkler protection is for the new connector and the existing Parish Hall.

Project Manual:

1. None

Drawings:

Architectural

- 1. Revise Sheet A3.2.
- 2. Revise Sheet A3.4
- 3. Revise Sheet A3.6.
- 4. Revise Sheet A4.1.
- 5. Revise Sheet A4.2.
- 6. Revise Sheet A7.3.

Civil

1. No revisions.

Structural

1. No revisions

MEP

- 1. Revise Sheet M2.1
- 2. Revise Sheet E1.1.
- 3. Revise Sheet E2.1.
- 4. Revise Sheet E3.1.
- 5. Revise Sheet E3.2.
- 6. Revise Sheet E3.3.
- 7. Revise Sheet E6.1.
- 8. Revise Sheet E6.2.
- 9. Revise Sheet P0.3.
- 10.

<u>Fire</u>


1. No Revisions

Martsolf Architecture

January 15, 2024 Addendum #1 – Martsolf Architecture Project No. 2307

St Jude Catholic Church Parish Hall Remodel & Connector Mansfield, Texas

End of Addendum #1

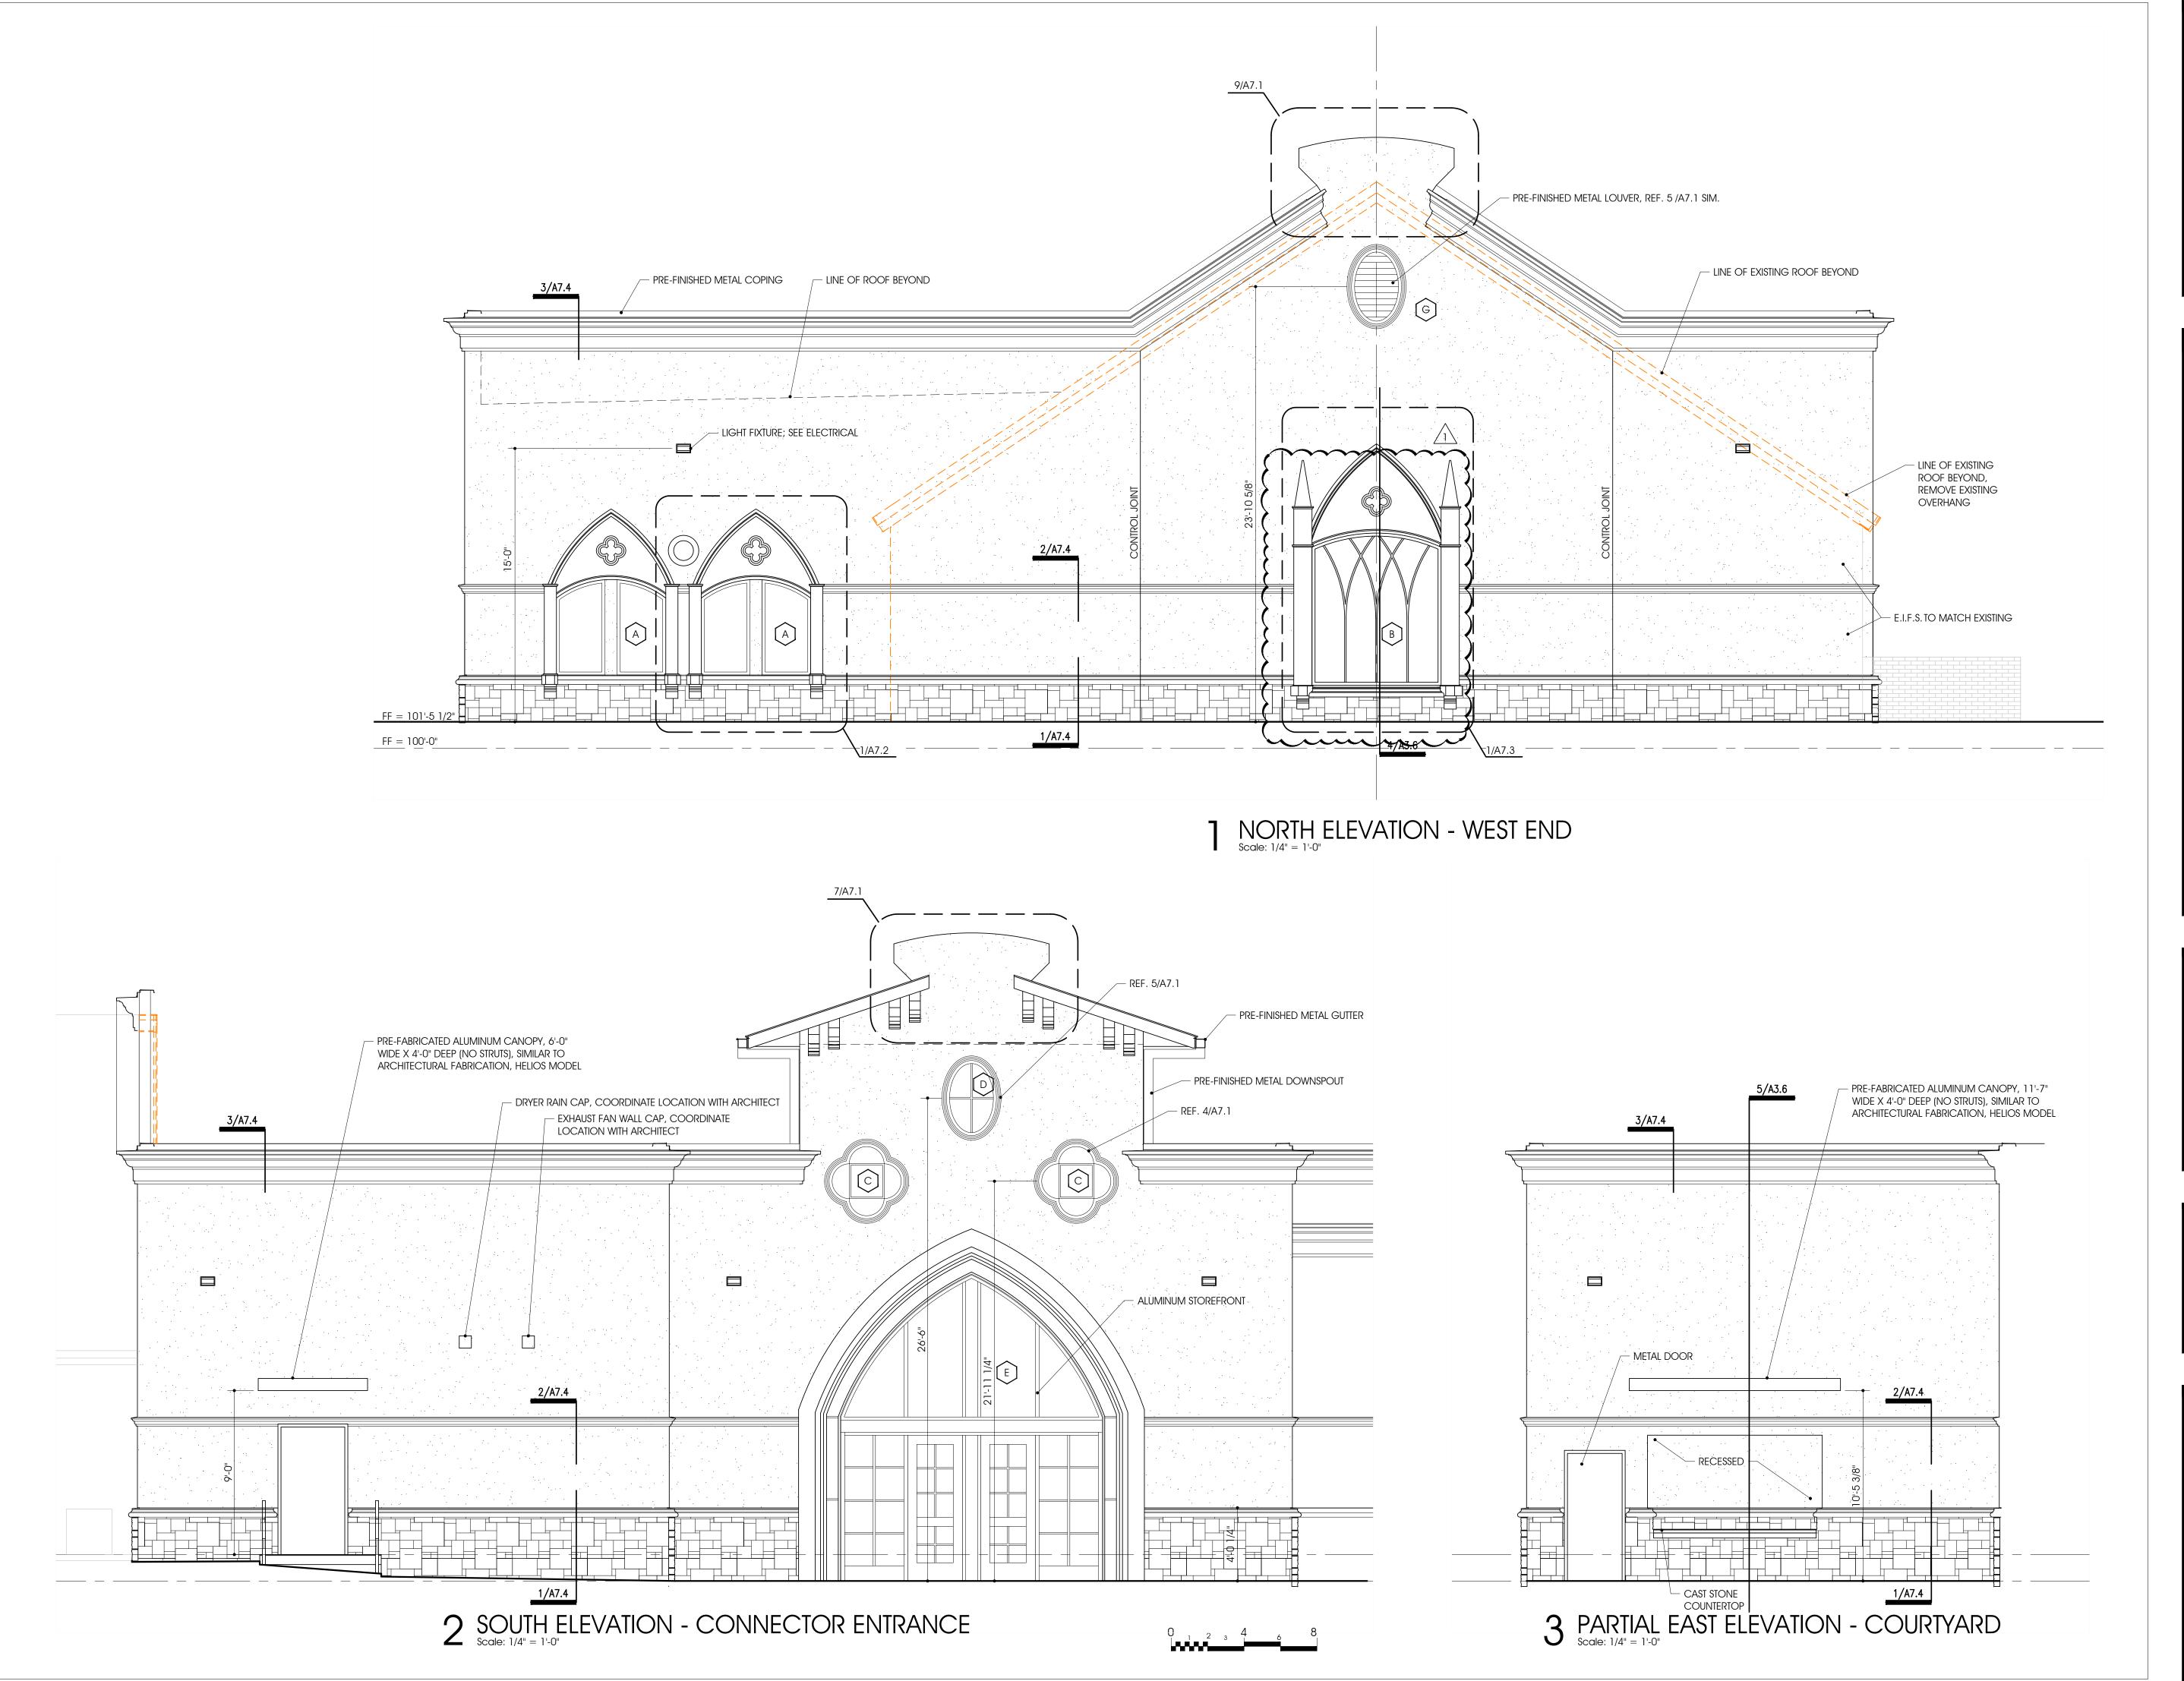


ARCHITECTURE SCOTT MARTSOLF - ARCHITECT

815 Daggett Avenue Fort Worth, Texas 76104 Phone: (817) 820-0005


> ST. JUDE CATHOLIC CHURCH

PARISH HALL REMODEL & CONNECTOR

500 e dallas st. Mansfield, TX 76063

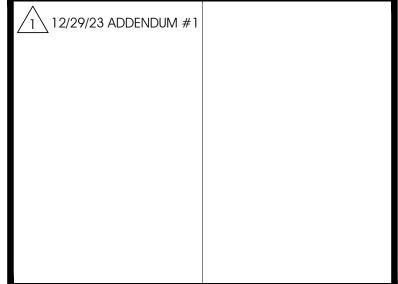

Drawing Title: EXTERIOR ELEVATIONS				
Project No.	Date:			
2307	12/20/2023			
	Sheet No.			
	A3.2			

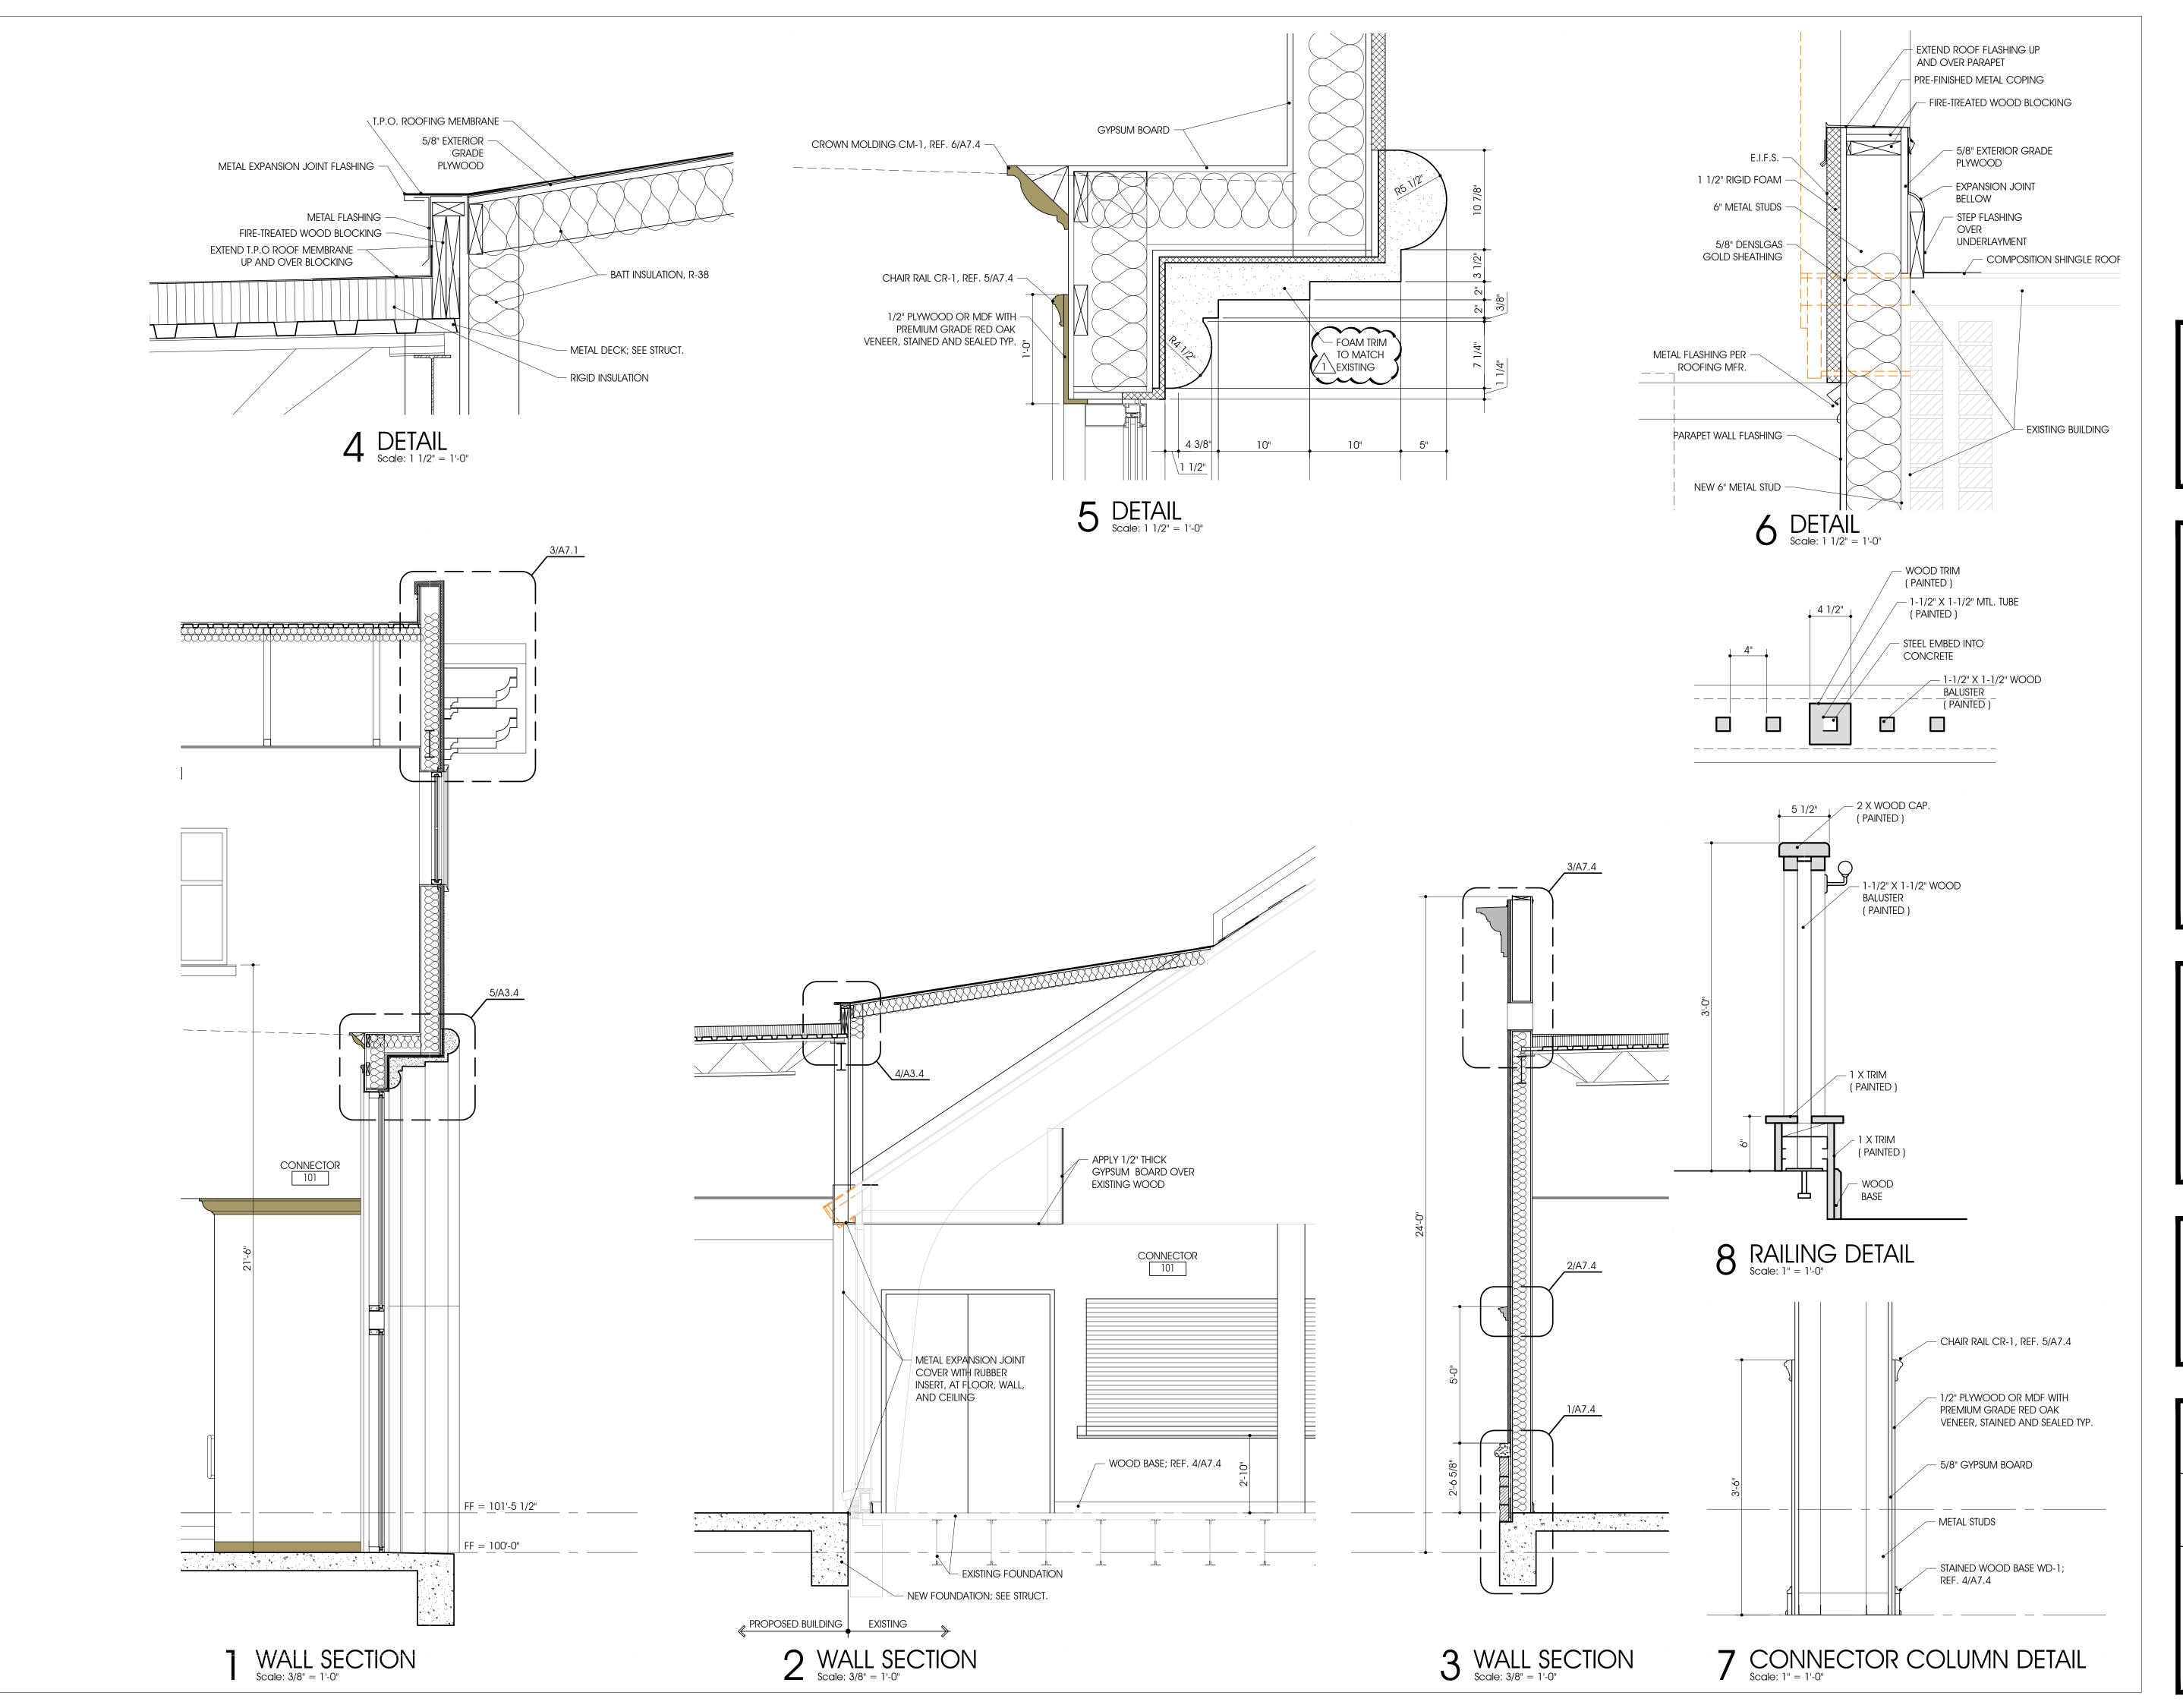

ARCHITECTURE
SCOTT MARTSOLF - ARCHITECT

815 Daggett Avenue
Fort Worth, Texas 76104

Phone: (817) 820-0005

ST. JUDE
CATHOLIC
CHURCH

PARISH HALL
REMODEL &
CONNECTOR

1 2/29/23 ADDENDUM #1

500 E DALLAS ST.

MANSFIELD, TX 76063

PERMIT SET


Project No.

2307

Date:
1/12/2024

Sheet No.

A3.4

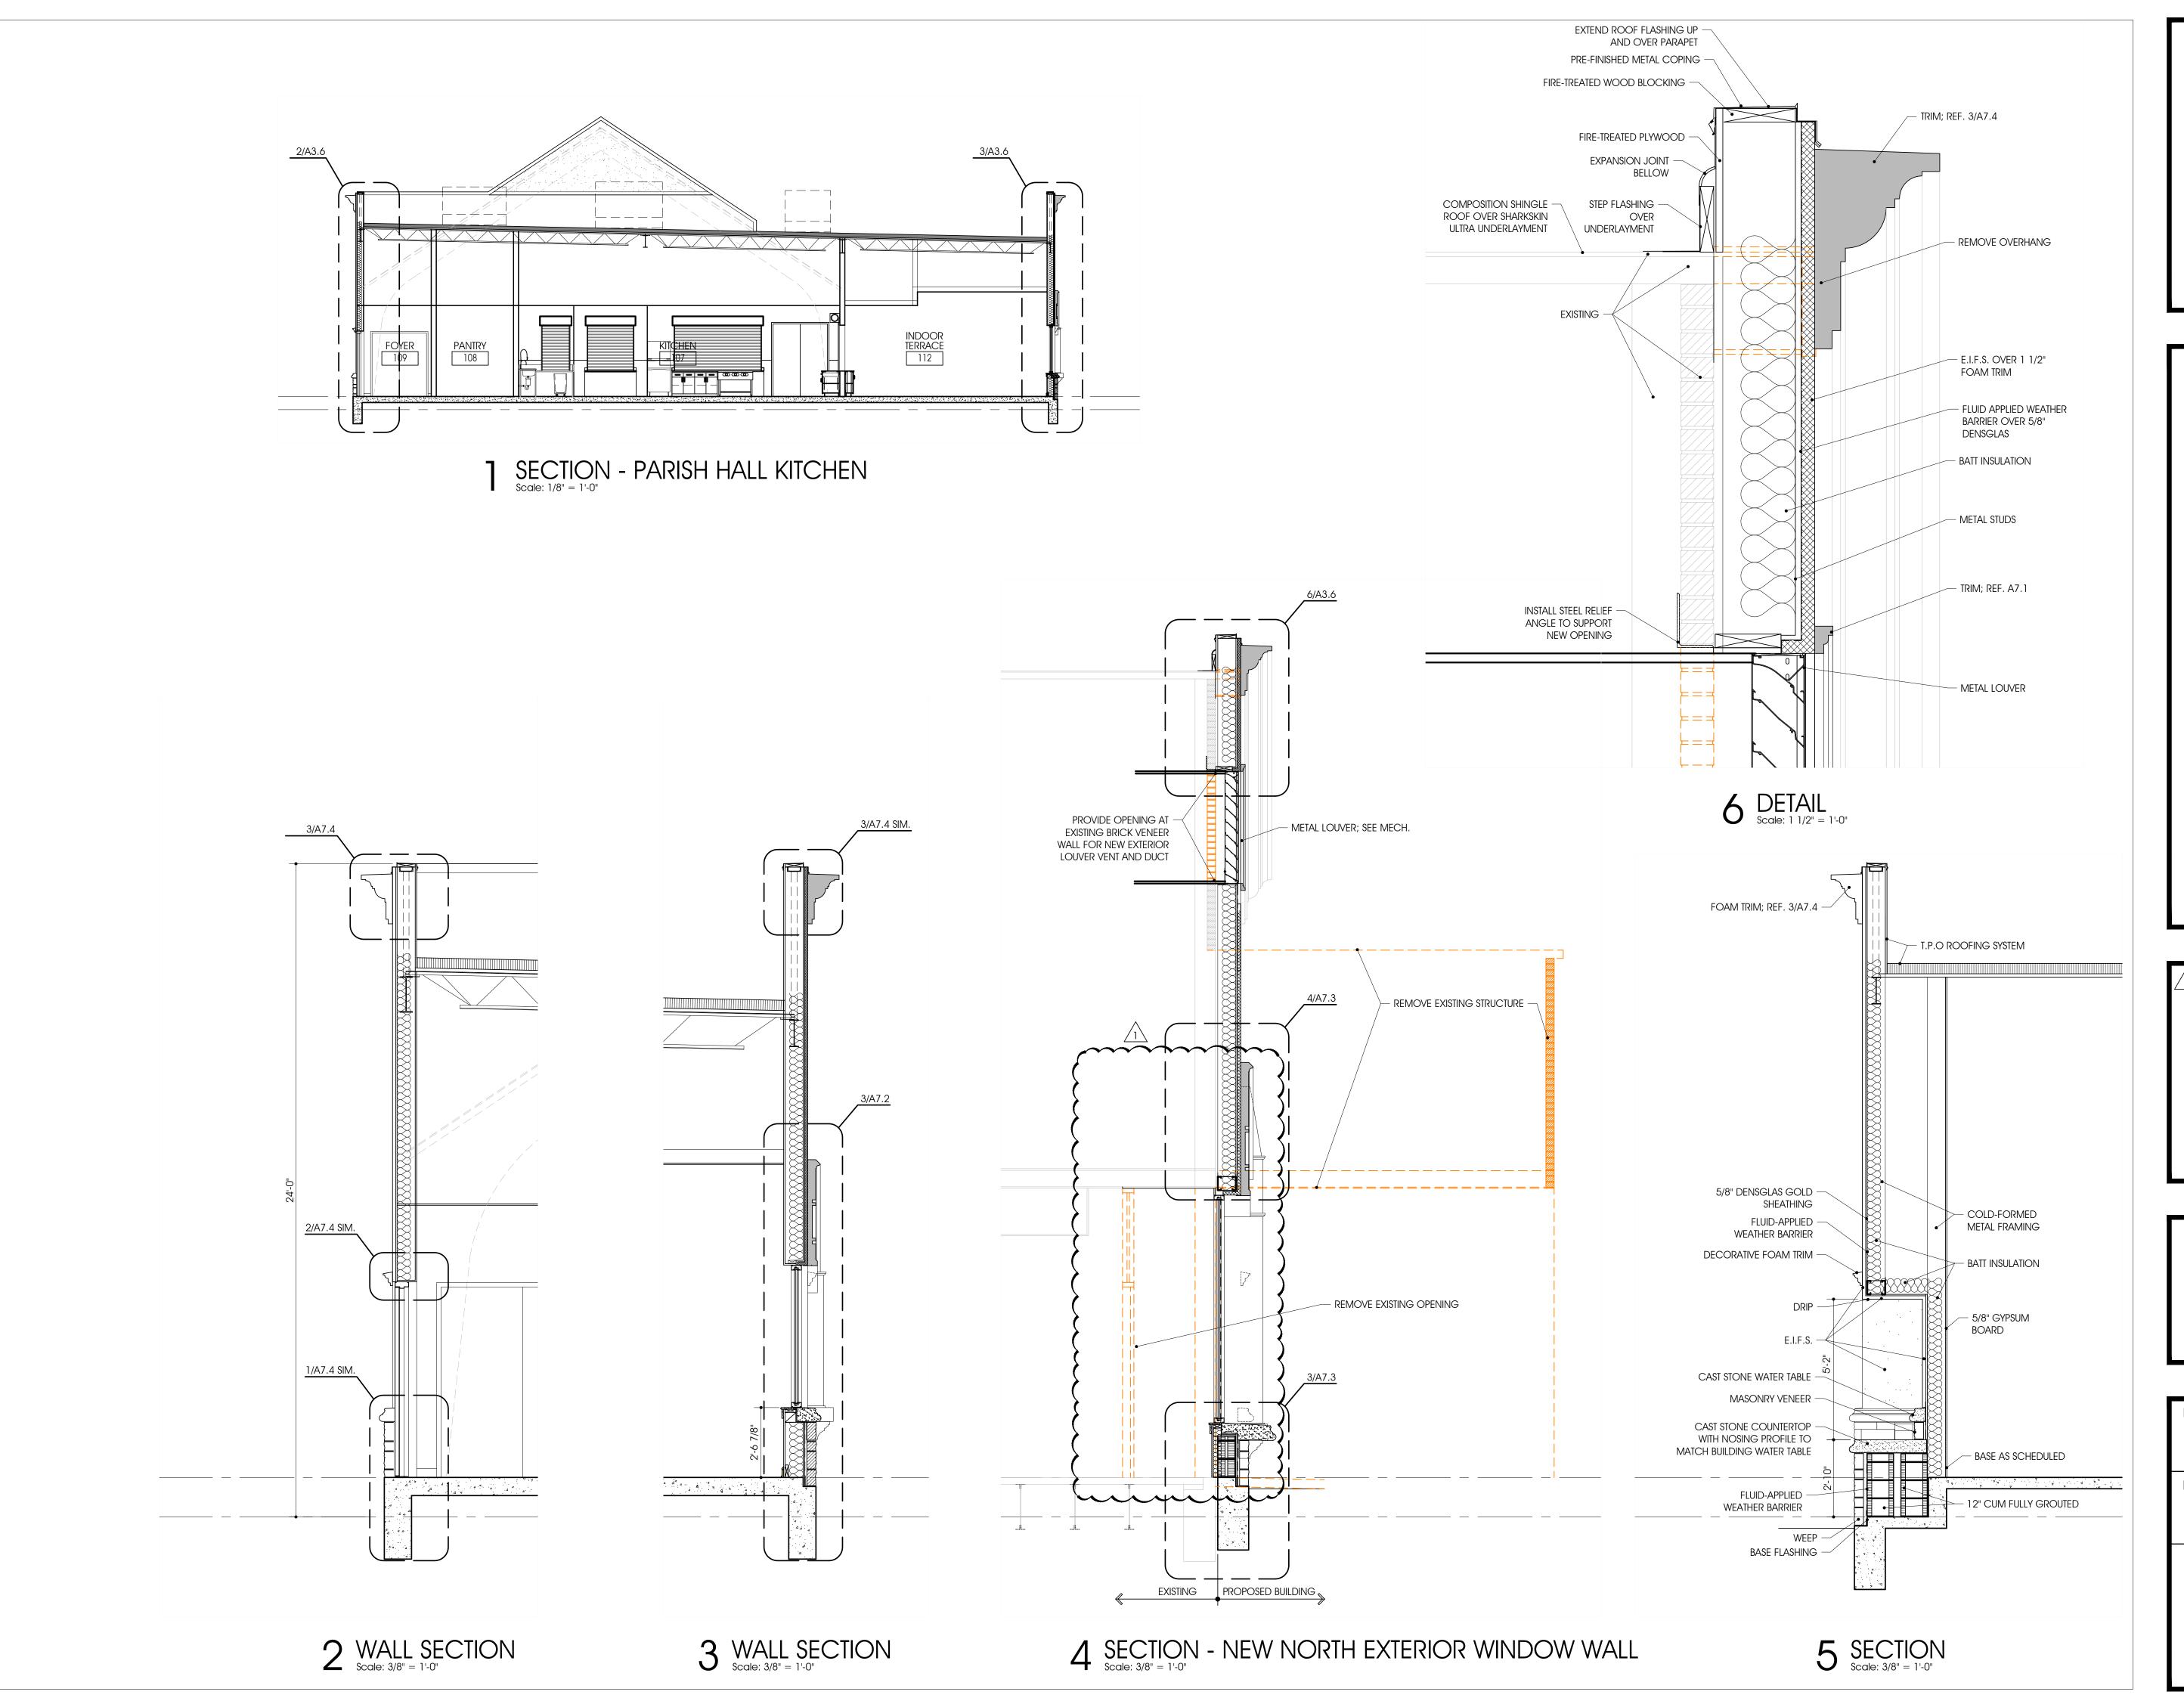

ARCHITECTURE
SCOTT MARTSOLF - ARCHITECT

815 Daggett Avenue
Fort Worth, Texas 76104

Phone: (817) 820-0005


ST. JUDE CATHOLIC CHURCH

PARISH HALL REMODEL & CONNECTOR

500 e dallas st. Mansfield, TX 76063

12/29/23 ADDENDUM #1

Drawing Title: WALL SECTIONS				
Project No.	Date:			
2307	12/20/2023			
	Sheet No.			
	A3.6			

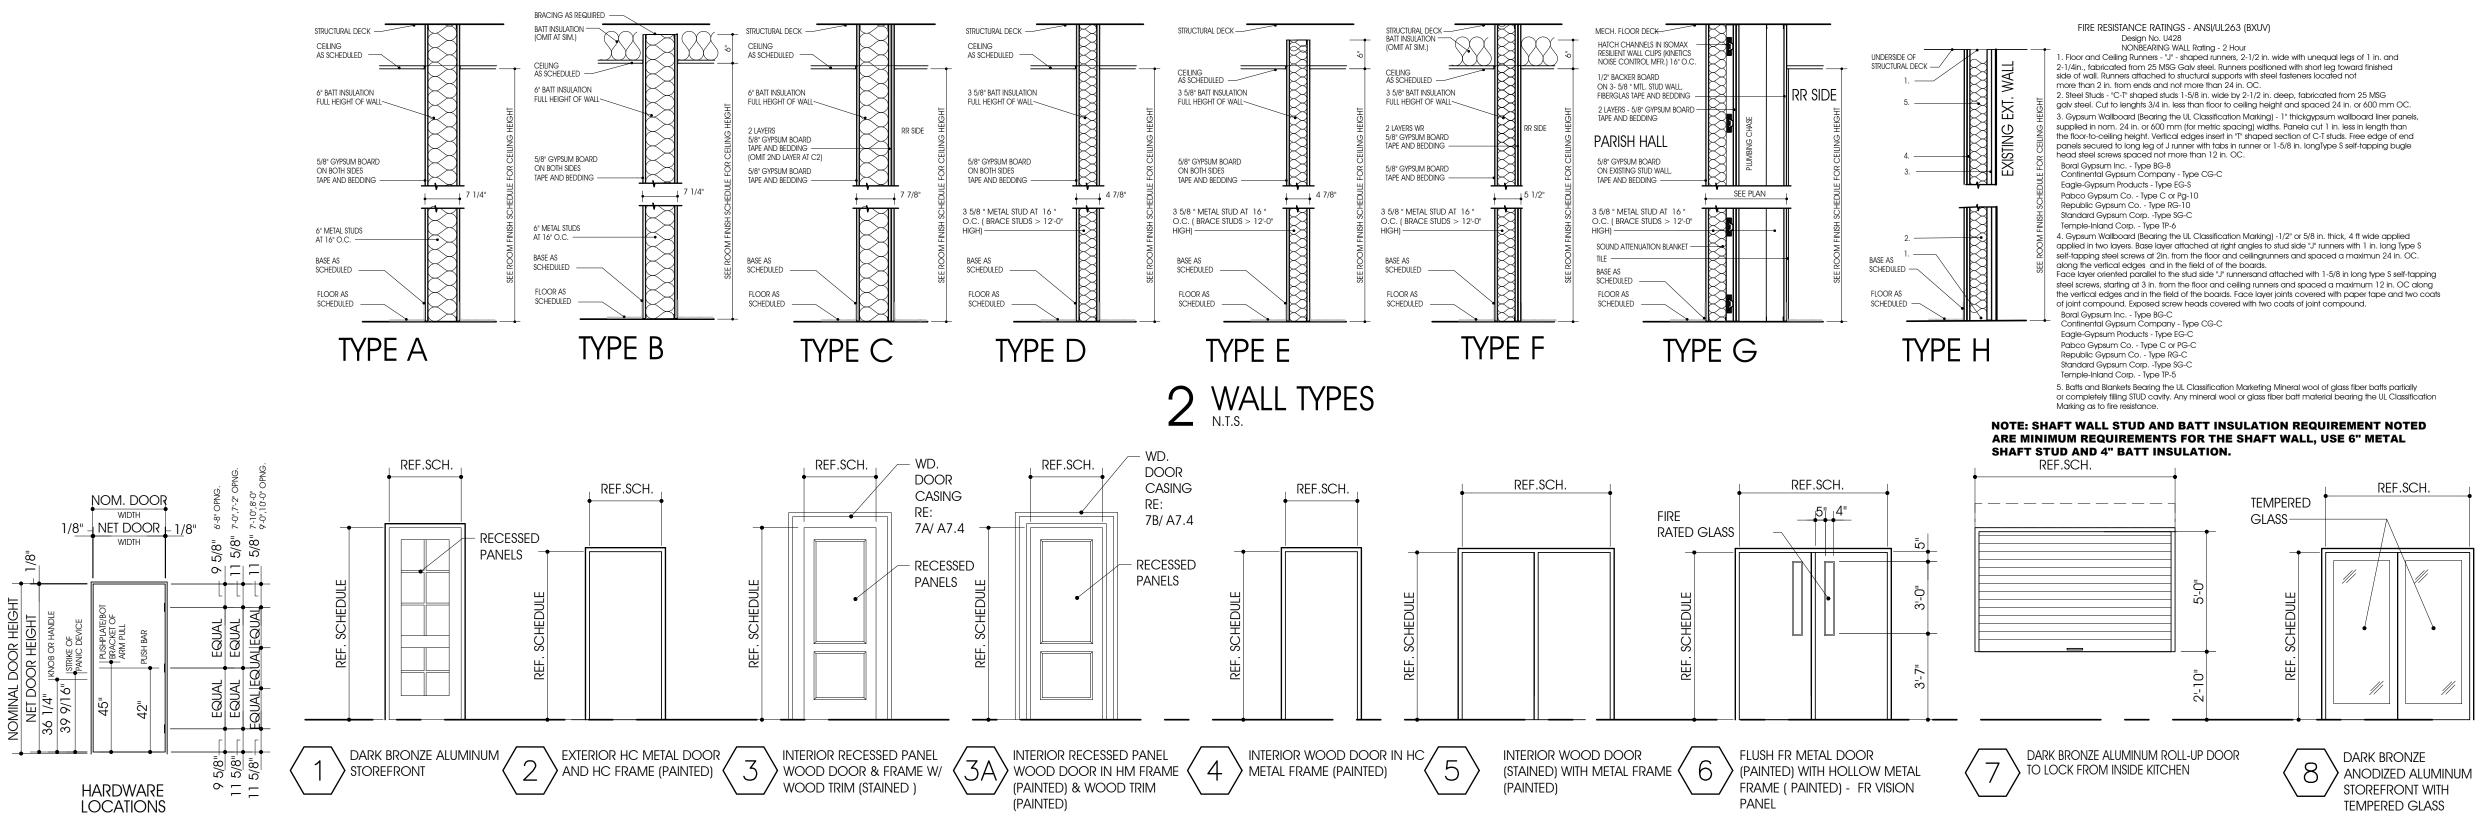

1 DOORS TYPES

	DOOR SCHEDULE					
REVISION MARKS	DOOR MARK	TYPE	FIRE RATED MIN.	SIZE	HDW.	REMARKS
1	101A	1		3'-0" x 8'-0"	<u> </u>	3.)
1	101B	1		3'-0" x 8'-0"	<u> </u>	3.)
1	101C	1		3'-0" x 8'-0"	- 	3.)
1	101D	1		3'-0" x 8'-0"	<u> </u>	3.)
1	101E	6	90 MIN	PR. 3'-0" x 8'-0"	<u> </u>	(3.)
1	101F	6	90 MIN	PR. 3'-0" x 7'-0"	(3.)
	102	3		3'-0" x 8'-0"		
	103	3		3'-0" x 8'-0"		
	104	3		3'-0" x 8'-0"		
	105	3		3'-0" x 8'-0"		
	107A	4		3'-0" x 8'-0"		
	107B	7		9'-0" x 5'-0"		
	107C	7		5'-0" x 5'-0"		
	107D	7		3'-0" x 5'-0"		
	108A	4		3'-0" x 7'-0"		
	108B	4		3'-6" x 7'-0"		
1	109	2		3'-6" x 7'-0"	(3.)
•	110	4		3'-0" x 7'-0"		
	111	2		3'-0" x 7'-0"		
	113A	3		3'-0" x 8'-0"		
	113B			16'-8" x 10'-0"		2.
1	114A	3A		3'-6" x 8'-0"		3.)
	114B	3A		PR. 3'-0" x 8'-0"		
1	114C	1		PR. 3'-0" x 8'-0"		3.)
	116A	3A		PR. 3'-0" x 8'-0"		
	116B	3A		PR. 3'-0" x 8'-0"		
	118	4		3'-0" x 7'-0"		
	119	4		3'-0" x 7'-0"		
	121	4		3'-0" x 7'-0"		
	122	4		PR. 3'-0" x 7'-0"		
	123	4		PR. 3'-0" x 7'-0"		
/1	124A	1		3'-0" x 8'-0"		3.)
<u></u>	124B	1		3'-0" x 8'-0"	(3.)
1						

NUMBERED NOTES:

- 1. ONE LEAF WITH AUTOMATIC HOLD-OPENS TIED TO FIRE ALARM
- 2. PAIRED PANEL OPERABLE PARTITION
 3. PROVIDE PANIC HARDWARE.

ROOM FINISH	
SCHEDULE LEGEND)

CP-1	FLOORS CARPET TILE, 24" X 24"
LVT-1	LUXURY VINYL TILE
PC	POLISHED CONCRETE

SC SEALED CONCRETE

T-1 TERRAZZO TILE, 24" X 24"

WOOD $\frac{3}{4}$ X 6 T&G RED OAK (STAINED)

BASE

CT-1 CERAMIC TILE

RB RUBBER BASE

T-1 TERRAZZO TILE - SEE ELEVATIONS FOR HEIGHT

WD-1 WOOD BASE - SEE A8.1 FOR LOCATIONS

WD-2 WOOD BASE - SEE A8.1 FOR LOCATIONS

WALL

CT-1 GLAZED CERAMIC TILE, 4" X 12", 48" TALL WAINSCOT WITH METAL CAP, PAINTED GYPSUM BOARD ABOVE

GB PAINTED GYPSUM BOARD

T-1 TERRAZZO TILE, 24" X 24" - SEE ELEVATIONS FOR HEIGHT

ES PAINTED EXPOSED STRUCTURE

GB PAINTED GYPSUM BOARD

LI-1 2X2 LAY-IN ACOUSTICAL TILE

LI-2 2X2 LAY-IN VINYL FACED TILE

NUMBERED FINISH NOTES:

 SEE INTERIOR ELEVATIONS FOR CERAMIC TILE WAINCOT LOCATION
 PAINT ALL NEW SHEETROCK WALLS AND EXISTING BRICK WALLS TO MATCH SHEETROCK COLOR.

R	OOM FINISH	H SC	CHE	DUL	E									
			FL:		ВА	\SE			WΔ	LLS		CL	Ū	
1BER				N	Е	S	W	N	Е	S	W			
ROOM NUMBER		REV.	COLOR/FINISH	COLOR/FIN.	HEIGHT	NUMBERED								
	ROOM NAME								_					NOTES
101	CONNECTOR		PC	WD-1	WD-1	WD-1	WD-1	GB	GB	GB	GB	GB	VARIES	
102	CLOSET		PC	WD-1	WD-1	WD-1	WD-1	GB	GB	GB	GB	LI-1	9'-0"	
103	FIRE PROTECTION		PC	RB	RB	RB	RB	GB	GB	GB	GB	LI-1	12'-0"	
104	CLOSET		PC	WD-1	WD-1	WD-1	WD-1	GB	GB	GB	GB	GB	9'-0"	
105	CLOSET		PC	WD-1	WD-1	WD-1	WD-1	GB	GB	GB	GB	GB	9'-0"	
106	HALL													
107	KITCHEN		LVT	CT-1	CT-1	CT-1	CT-1	GB/CT-1	GB/CT-1	GB/CT-1	GB/CT-1	LI-1	10'-0"	
108	PANTRY		LVT	RB	RB	RB	RB	GB	GB	GB	GB/CT-1	LI-1	10'-0"	1.
109	FOYER		LVT	RB	RB	RB	RB	GB	GB	GB	GB	GB	10'-0"	
110	TOILET		T-1	T-1	T-1	T-1	T-1	T-1	T-1	T-1	T-1	GB	9'-0"	
111	STORAGE		SC	RB	RB	RB	RB	GB	GB	GB	GB	GB	9'-0"	
112	INDOOR TERRACE		PC	WD-1		WD-1		GB		GB		GB	11'6"	
113	MEETING		PC	WD-1	WD-1	WD-1	WD-1	GB	GB	GB	GB	GB	11'6"	
114	PARISH HALL		CP-1	WD-2	WD-2	WD-2	WD-2	GB	GB	GB	GB	EXISTING	VARIES	2.
115	PLATFORM		WOOD	WD-1	WD-1			GB	GB			GB	VARIES	
116	BACK		LVT	RB	RB	RB	RB						EXISTING	
117	HALL		LVT	RB	RB	RB	RB						EXISTING	
118	WOMEN		T-1	T-1	T-1	T-1	T-1	T-1	T-1	T-1	T-1	GB	EXISTING	
119	ELECTRICAL		T-1	T-1	T-1	T-1	T-1	GB	GB	GB	GB	GB	EXISTING	
120	FOYER		T-1	T-1	T-1	T-1	T-1	GB	GB	GB	GB	GB	EXISTING	
121	MEN		T-1	T-1	T-1	T-1	T-1	T-1	T-1	T-1	T-1	GB	EXISTING	
122	STORAGE		CP-1	RB	RB	RB	RB	GB	GB	GB	GB	EXISTING	EXISTING	
123	STORAGE		CP-1	RB	RB	RB	RB	GB	GB	GB	GB	EXISTING	EXISTING	
124	FOYER		PC	WD-1	WD-1	WD-1	WD-1	GB	GB	GB	GB	GB	VARIES	SEE WALL SECTIONS



815 Daggett Avenue Fort Worth, Texas 76104 Phone: (817) 820-0005


ST. JUDE CATHOLIC CHURCH PARISH HALL REMODEL & CONNECTOR

500 E DALLAS ST. MANSFIELD, TX 76063

1/15/24 ADDENDUM #1	

PERMIT SET

	Drawing Title: ROOM FINISH DOOR Project No.	H SCHEDULE, TYPES Date:
	2307	1/12/2024
		Sheet No.
		A4.1

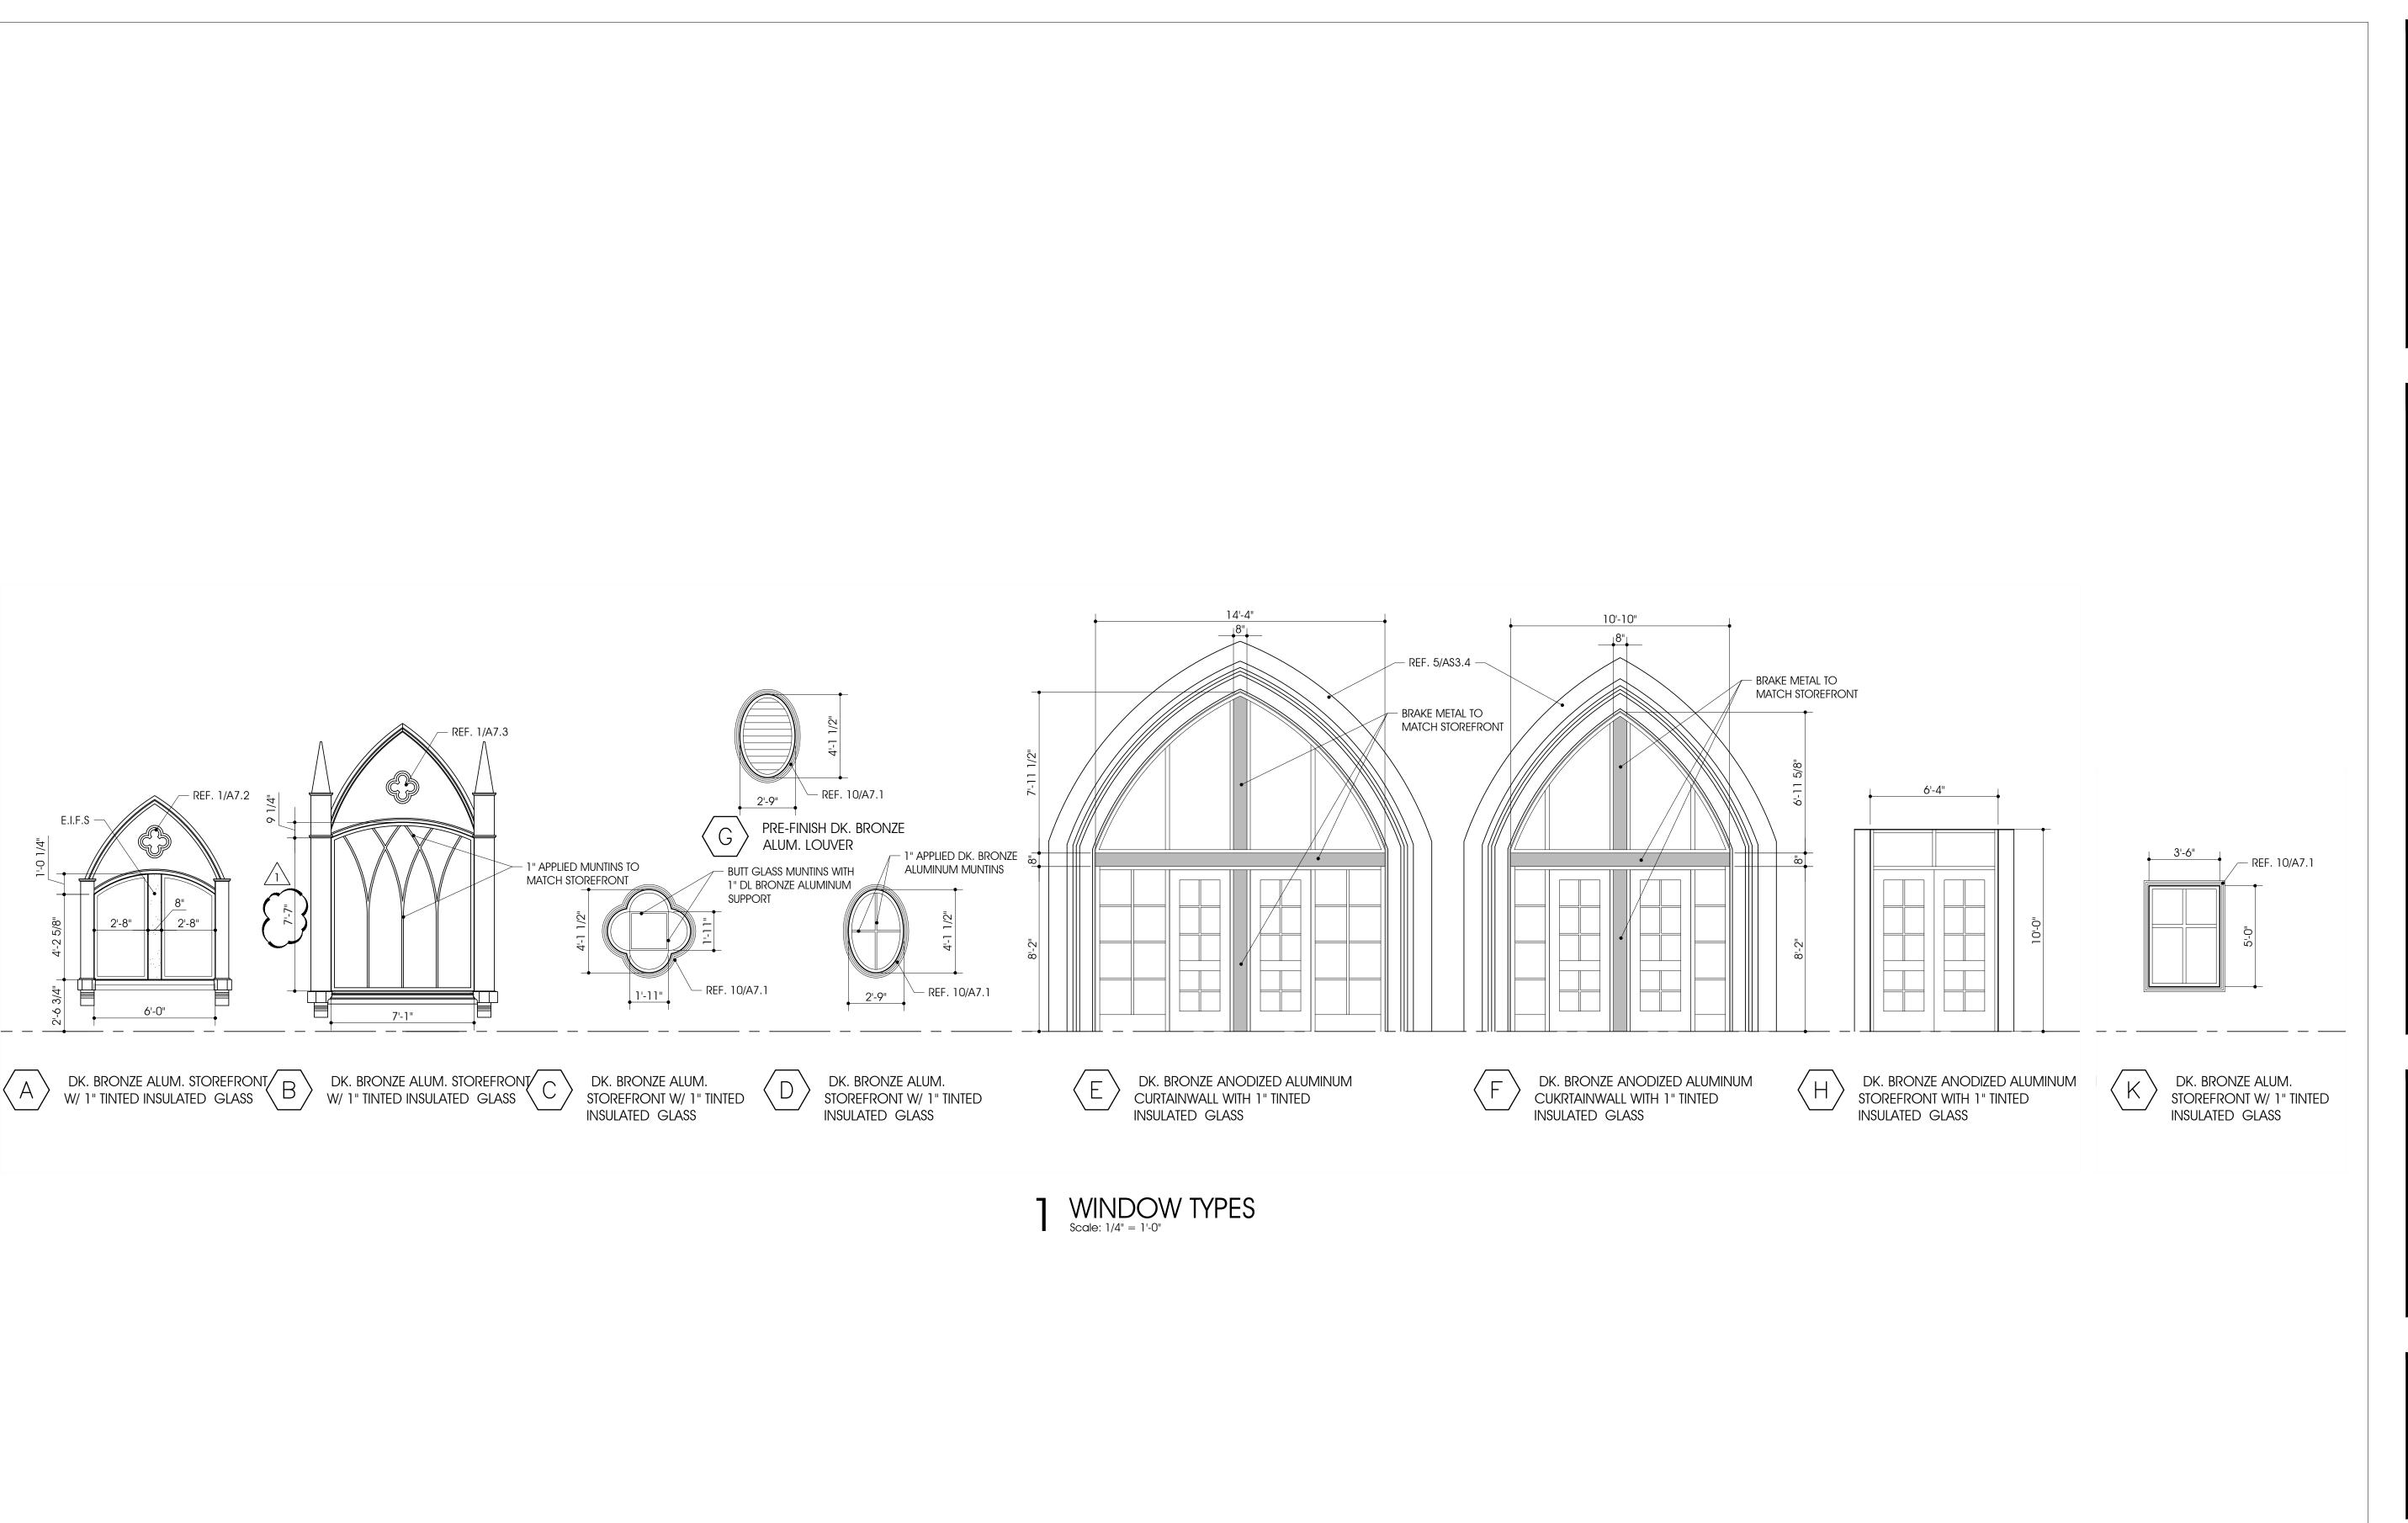

ALL GLAZING FOR DOORS
AND WINDOWS TO BE
TEMPERED WHERE REQUIRED
BY CODE

AT A MINIMUM, PROVIDE PEEL
AND STICK FLEXIBLE
MEMBRANE FLASHING AT ALL
EXTERIOR PENETRATIONS AND
OPENINGS TO PROVIDE
WATERTIGHT ENVELOPE


ARCHITECTURE SCOTT MARTSOLF - ARCHITECT

815 Daggett Avenue Fort Worth, Texas 76104 Phone: (817) 820-0005


> ST. JUDE CATHOLIC CHURCH

PARISH HALL REMODEL & CONNECTOR

500 E DALLAS ST. MANSFIELD, TX 76063

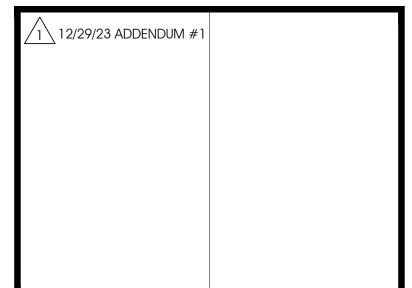

Drawing Title:					
WINDOW TYPES					
Project No.	Date:				
2307	12/20/2023				
	Sheet No.				
	A4.2				

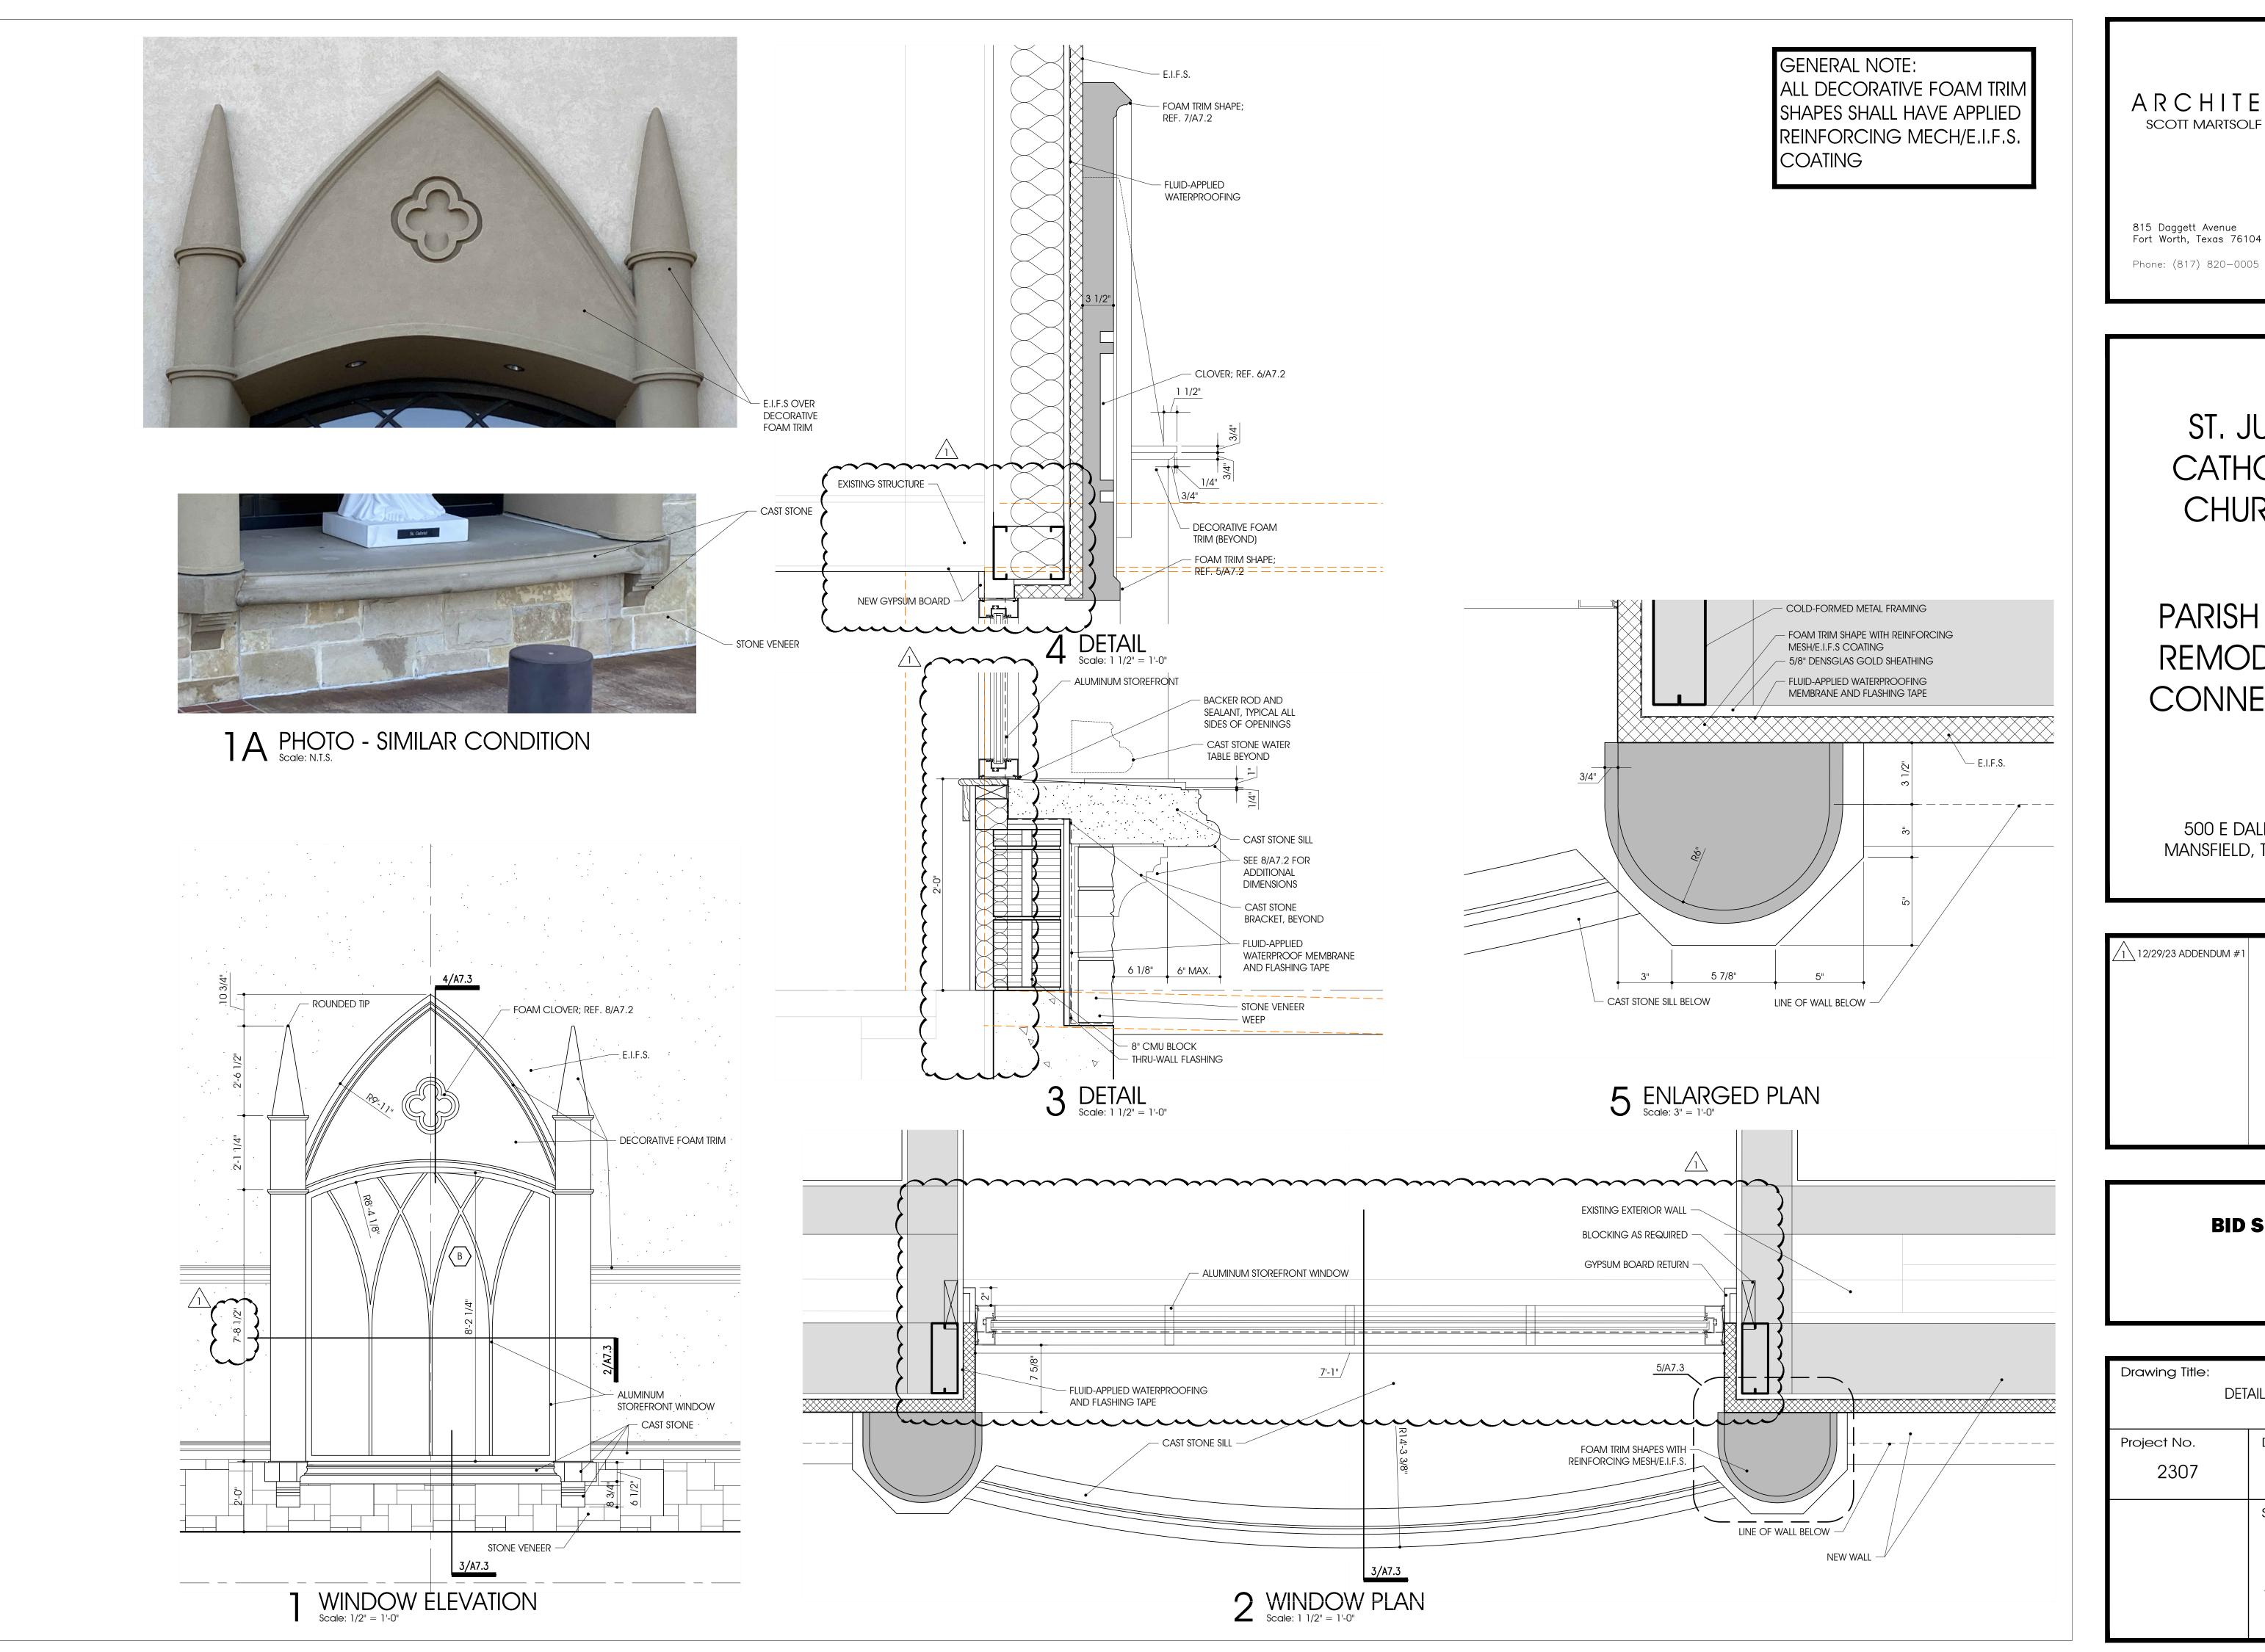


ARCHITECTURE SCOTT MARTSOLF - ARCHITECT

815 Daggett Avenue Fort Worth, Texas 76104


ST. JUDE CATHOLIC CHURCH

PARISH HALL REMODEL & CONNECTOR

500 E DALLAS ST. MANSFIELD, TX 76063

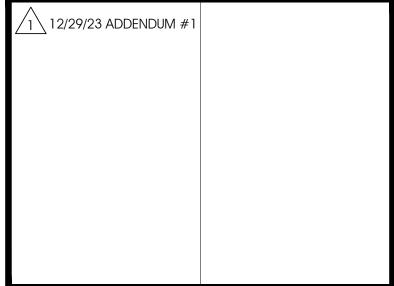


Drawing Title: DETAILS					
Project No.	Date:				
2307	12/20/2023				
	Sheet No.				
	A7.3				

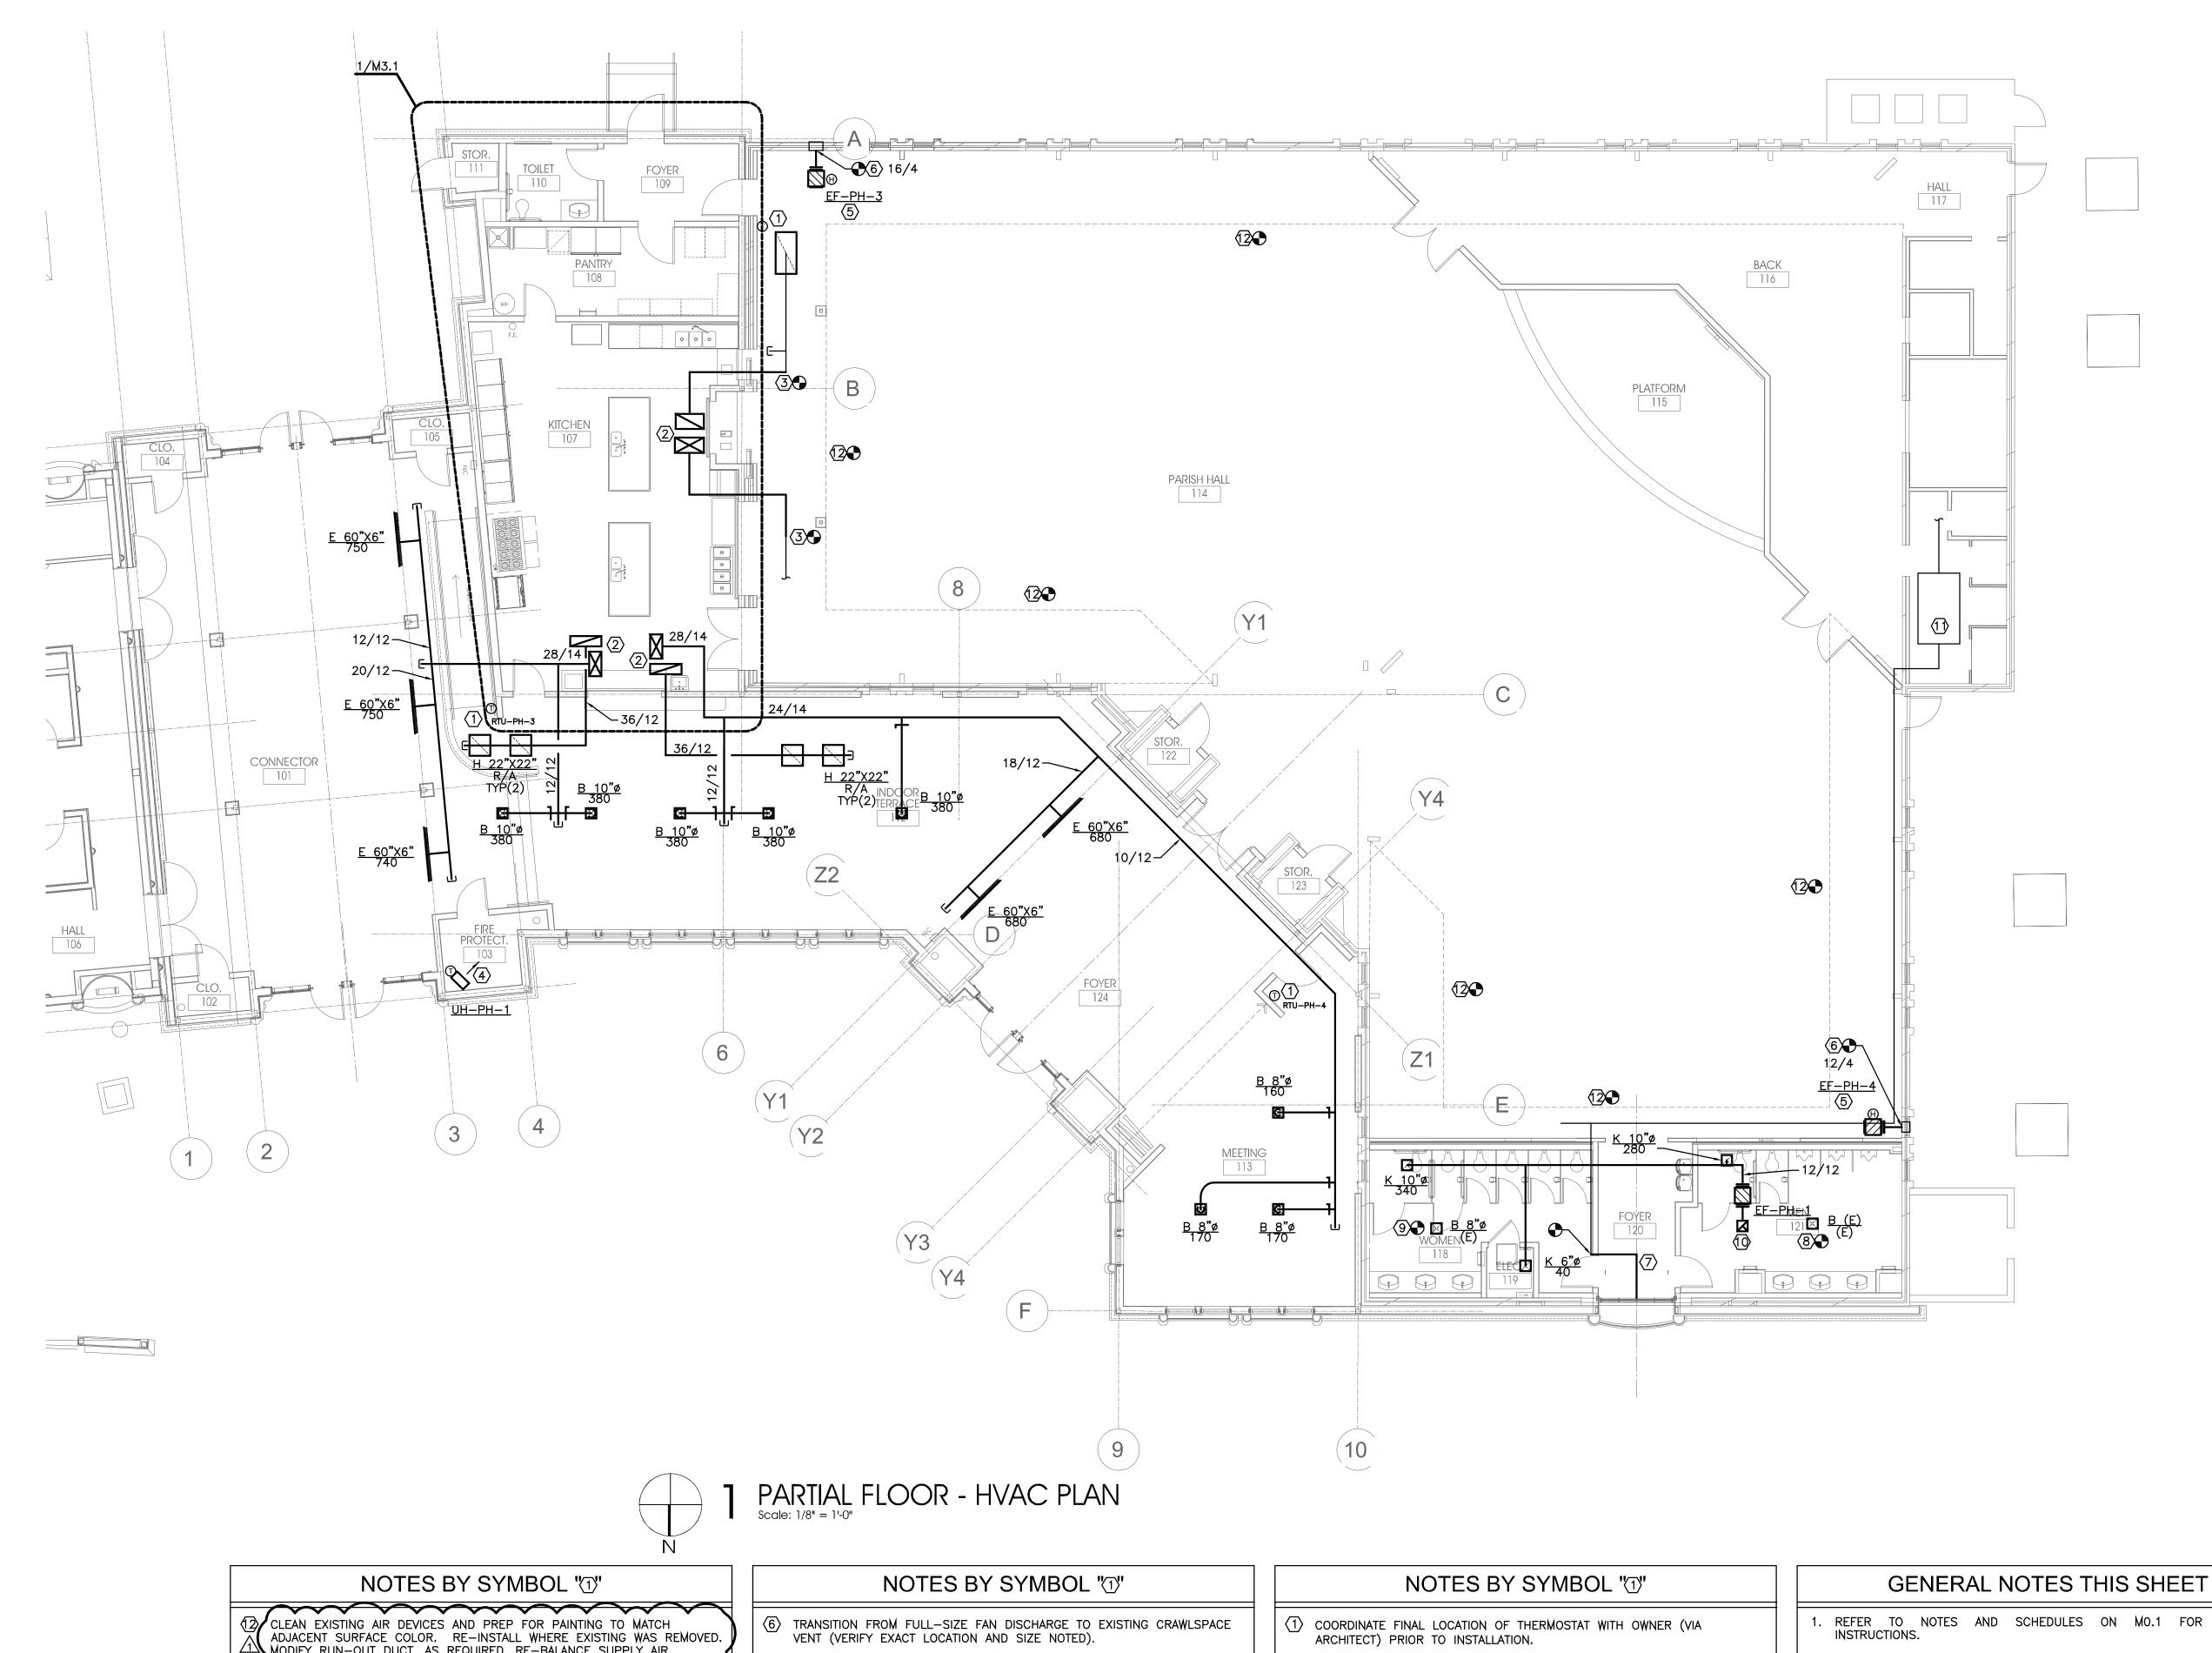

MODIFY RUN-OUT DUCT, AS REQUIRED, RE-BALANCE SUPPLY AIR DEVICES TO VALUES NOTED IN DEMOLITION PHASE.

- $\langle \overline{7} \rangle$ transition from full face size outdoor air intake louver to EXISTING OUTDOOR AIR DUCT SIZE (FIELD VERIFY). REFER TO ARCHITECTURAL FOR LOUVER LOCATION. LOUVER FACE AREA SHALL MATCH OR EXCEED AREA OF EXISTING OUTDOOR AIR LOUVER MEASURED AT THE DEMOLITION PHASE,
- (8) CONNECT RUN-OUT FROM DEMOLISHED AIR DEVICE TO NEW AIR DEVICE WITH SAME NECK SIZE AS EXISTING RUN-OUT. BALANCE TO AIR FLOW VALUE MEASURED AT DEMOLITION PHASE.
- (9) 8-INCH DIAMETER RUN-OUT FROM NEAREST BRANCH SUPPLY DUCT OF EQUIVALENT SIZE OR LARGER TO NEW AIR DEVICE. BALANCE TO SUM OF AIR FLOW VALUE MEASURED AT DEMOLITION PHASE FOR EACH RESTROOM.
- \bigcirc 12/12 UP TO EXHAUST VENT ON ROOF.
- (11) EXISTING AIR HANDLING UNIT TO REMAIN SHOWN FOR REFERENCE
- 2 TRANSITION FROM FULL-SIZE ROOFTOP UNIT SUPPLY/RETURN AIR OPENING TO/FROM SIZE SHOWN ON PLAN AT ROOF DECK. REFER TO M2.2 FOR CONTINUATION. REFER TO DETAIL 1/M4.1 3/M4.1 FOR ADDITIONAL INSTRUCTIONS.
- (3) CONNECT EXISTING SUPPLY AND RETURN WHERE EXISTING WAS REMOVED, USING SAME DUCT SIZES AS EXISTING.
- (4) COORDINATE LOCATION OF UNIT HEATER WITH OTHER EQUIPMENT, PIPING AND ACCESSORIES IN ROOM.
- (5) CRAWLSPACE VENTILATION FAN SUSPENDED IN CRAWLSPACE. PROVIDE WITH 1/2-INCH STAINLESS STEEL MESH INLET SCREEN AND HUMIDISTAT SET TO ENERGIZE FAN WHEN CRAWLSPACE HUMIDITY IS ABOVE 60-PERCENT. SEE FAN SCHEDULE ON MO.3 FOR ADDITIONAL, REQUIRED ACCESSORIES,
- REFER TO NOTES AND SCHEDULES ON MO.1 FOR ADDITIONAL
- RE-BALANCE ALL DUCTED GRILLES, REGISTERS, AND DIFFUSERS WITHIN LIMITS OF CONSTRUCTION TO VALUES MEASURED PRIOR TO DEMOLITION. REPORT DISCREPANCIES TO ARCHITECT/ENGINEER.

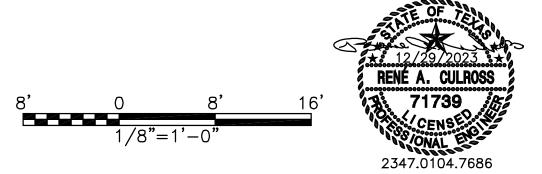

MEP Consultant Rene' A. Culross Rene' A. Culross, P.E., PLLC 1820 Hunting Green Drive Fort Worth, TX 76134 817-798-6642 raculross@gmail.com F-12230

ARCHITECTURE SCOTT MARTSOLF - ARCHITECT


815 Daggett Avenue Fort Worth, Texas 76104

Phone: (817) 820-0005


ST. JUDE CATHOLIC CHURCH

PARISH HALL REMODEL & CONNECTOR BUILDING

500 E DALLAS ST. MANSFIELD, TX 76063

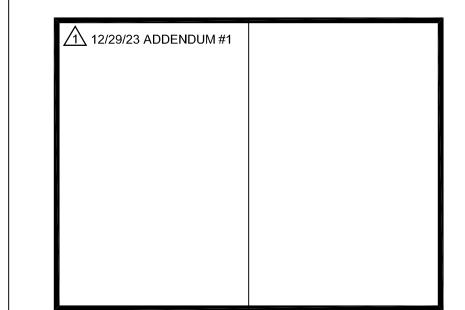

Drawing Title:					
PARTIAL FLOOR - HVAC PLAN					
Project No.	Date:				
2307	12/29/2023				
	Sheet No.				
	M2.1				

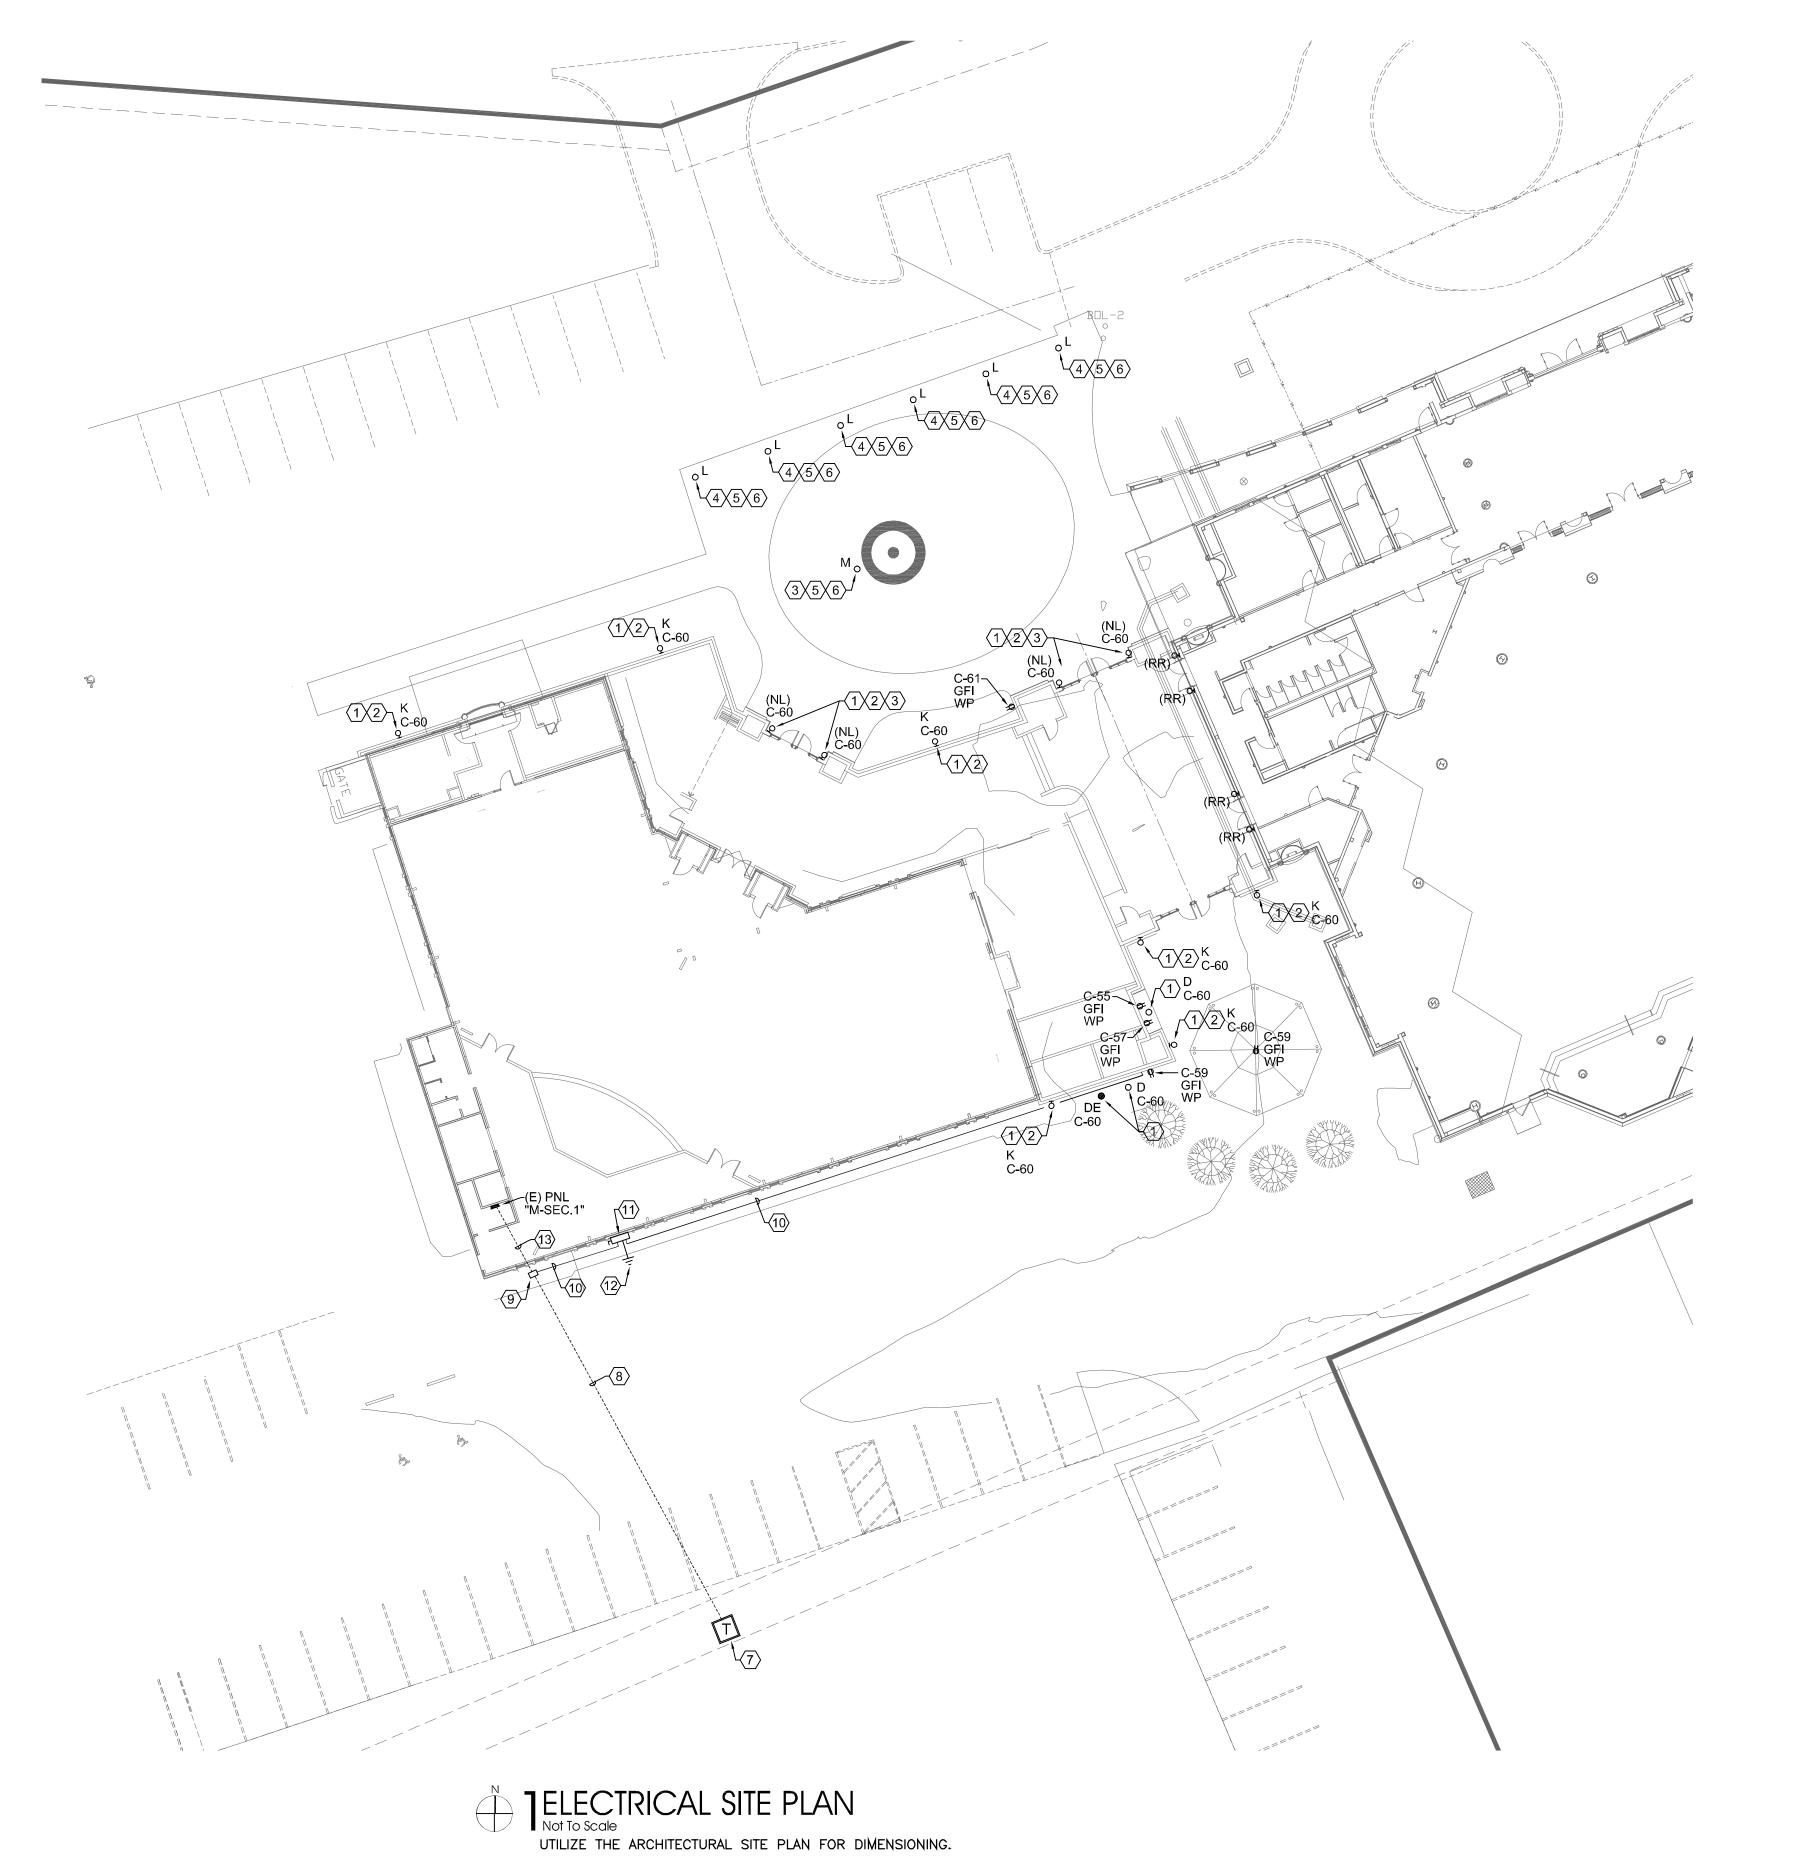

- 1. RE: E0.1 FOR ELECTRICAL SYMBOLS, ADDITIONAL GENERAL NOTES, AND ABBREVIATIONS.
- RE: E0.2 FOR ELECTRICAL SPECIFICATIONS.
- RE: E0.3 FOR LIGHTING CONTROL DETAILS
- 4. RE: E5.1 FOR BRANCH WIRING SCHEDULE FOR WIRE
- 5. RE: E6.1 AND E6.2 FOR PANELBOARD SCHEDULES.
- RE E6.2 FOR LIGHT FIXTURE SCHEDULE.
- RE: E6.2 FOR MECHANICAL / ELECTRICAL SCHEDULE.
- LIGHTING CONTROLS TO INCLUDE "DAYLIGHTING ZONE" REQUIREMENTS.
- PROVIDE ADDITIONAL CONDUCTOR WITHIN CIRCUITS WHERE REQUIRED FOR FOR UNSWITCHED POWER TO EXIT SIGNS AND EMERGENCY BALLAST / DRIVER SYSTEMS.
- DESIGNATION REPRESENTS:
 (X) EXISTING FLECTRICAL DEVICE TO
- (X) EXISTING ELECTRICAL DEVICE TO REMAIN AS IS.
 (R) EXISTING ELECTRICAL DEVICE TO TO BE
- REMOVED IN ITS ENTIRETY.

 (RR) REMOVE AND RELOCATED EXISTING ELECTRICAL
- (NL) NEW LOCATION FOR EXISTING RELOCATED ELECTRICAL DEVICE.

NOTES BY SYMBOL "#"

- ROUTE LIGHTING BRANCH CIRCUITING THRU THE EXTERIOR LIGHTING CONTACTOR. RE: 1/E0.3 EXTERIOR LIGHTING CONTACTOR WIRING DETAIL FOR ADDITIONAL INFORMATION.
- COORDINATE MOUNTING HEIGHTS AND EXACT LOCATION OF LIGHT FIXTURE WITH THE ARCHITECTS PRIOR TO INSTALLATION.
- NEW LOCATION OF EXISTING RELOCATED LIGHT FIXTURE. COORDINATE WITH THE ARCHITECTS PRIOR TO INSTALLATION. REPLACE LAMPS WITH LED WATTAGE EQUIVALENT.
- INTERCEPT AND EXTEND EXISTING LIGHTING BRANCH CIRCUITING AND LIGHTING CONTROLS AND RE-CONNECT TO NEW OR EXISTING RELOCATED LIGHT FIXTURE.
- (5) RE: 3/E0.3 TYPICAL BOLLARD BASE DETAIL FOR ADDITIONAL INFORMATION.
- 6 COORDINATE EXACT LOCATION OF LIGHT FIXTURE WITH THE ARCHITECTS PRIOR TO INSTALLATION.
- $\langle \overline{7} \rangle$ EXISTING UTILITY TRANSFORMER TO REMAIN.
- 8 CONTACTOR TO SAW CUT THE EXISTING PAVING TO INSTALL (1) ONE NEW CONDUIT AS INDICATED AND INSTALL ADJACENT TO THE EXISTING EXISTING CONDUITS. RE: 1/E5.1 ELECTRICAL ONE-LINE DIAGRAM FOR ADDITIONAL INFORMATION.
- PROVIDE A QUAZITE PULL BOX ADJACENT TO THE NEW SERVICE DISCONNECT SWITCH. COVER TO HAVE THE THE LABEL "ELECTRICAL" AND GREEN IN COLOR. INSTALL PER MANUFACTURER'S RECOMMENDATIONS. VERIFY LOCATION TO INSTALL AND AVOID CONFLICTS WITH EXISTING CONDENSING UNIT(S) IN THIS AREA.
- VERIFY UNDERGROUND UTILITIES PRIOR TO TRENCHING THIS AREA FOR NEW FEEDERS TO BE INSTALLED. RE: 1/E5.1 ELECTRICAL ONE-LINE DIAGRAM FOR ADDITIONAL INFORMATION.
- NEW PROPOSED LOCATION FOR NEMA 3R SERVICE RATED DISCONNECT SWITCH. RE: 1/E5.1 ELECTRICAL ONE-LINE DIAGRAM FOR ADDITIONAL INFORMATION.
- BUILDING SERVICE ENTRANCE GROUNDING. RE: 3/E5.1 BUILDING SERVICE ENTRANCE GROUNDING DIAGRAM FOR ADDITIONAL INFORMATION.
- UTILIZE EXISTING CONDUITS FOR NEW FEEDER CONDUCTORS. RE: 1/E5.1 ELECTRICAL ONE-LINE DIAGRAM FOR ADDITIONAL INFORMATION.



MEP Consultant
Rene' A. Culross
Rene' A. Culross, P.E., PLLC
1820 Hunting Green Drive
Fort Worth, TX 76134
817-798-6642
raculross@gmail.com
F-12230

ARCHITECTURE SCOTT MARTSOLF - ARCHITECT

815 Daggett Avenue Fort Worth, Texas 76104

Phone: (817) 820-0005

ST. JUDE CATHOLIC CHURCH

PARISH HALL
REMODEL &
CONNECTOR
BUILDING

500 E DALLAS ST. MANSFIELD, TX 76063

12/29/23 ADDENDUM #1	

Drawing Title:	
E	ELECTRICAL SITE PLAN
Project No.	Date:
2307	12/29/2023
	Sheet No.
	E1.0



PARTIAL FLOOR - DEMOLITION PLAN | Scale: 1/8" = 1'-0"

NOTES BY SYMBOL "#" CONT.

- (19) EXISTING EXTERIOR LIGHT TO BE DISCONNECTED IN ITS ENTIRETY. DISCONNECT AND REMOVE EXISTING LIGHTING BRANCH CIRCUITING BACK TO ORIGIN (EXISTING EXTERIOR LIGHTING BRANCH CIRCUITING JUNCTION FEEDING OTHER EXTERIOR LIGHT FIXTURE REMAINING OR LIGHTING CONTROLS OR PANELBOARD).
- (20) EXISTING SURFACE MOUNTED RECEPTACLES ARE TO BE DISCONNECTED AND REMOVED. EXISTING EXPOSED CONDUIT AND ASSOCIATED CONDUCTORS ARE TO BE DISCONNECTED AND REMOVED BACK TO POINT OF ORIGIN (PANELBOARD).

NOTES BY SYMBOL "#" CONT.


- (16) EXISTING ELECTRICAL WATER COOLER TO BE DISCONNECTED AND RELOCATED. DISCONNECT AND MAKE SAFE THE EXISTING POWER BRANCH CIRCUITING (FIELD TRACE CCT B-11) TO BE RE-USED. RE: 1/E3.1 PARTIAL FLOOR - POWER AND DATA PLAN FOR ADDITIONAL INFORMATION.
- (17) EXISTING AIR HANDLER UNIT IS SCHEDULED FOR DEMOLITION. DISCONNECT, REMOVE EXISTING LOCAL DISCONNECTING MEANS, CONDUIT AND ASSOCIATED CONDUCTORS BACK TO THE POINT OF ORIGIN. LABEL EXISTING CIRCUIT BREAKER AS "SPARE".
- (18) EXISTING CONDENSING UNITS (2 TOTAL) IS SCHEDULED FOR DEMOLITION. DISCONNECT, REMOVE EXISTING LOCAL DISCONNECTING MEANS, CONDUIT AND ASSOCIATED CONDUCTORS BACK TO THE POINT OF ORIGIN. LABEL EXISTING CIRCUIT BREAKER AS "SPARE".

GENERAL NOTES

- RE: E0.1 FOR ELECTRICAL SYMBOLS, ADDITIONAL GENERAL NOTES, AND ABBREVIATIONS.
- RE: E0.2 FOR ELECTRICAL SPECIFICATIONS.
- RE: E0.3 FOR LIGHTING CONTROL DETAILS
- 4. RE: E5.1 FOR BRANCH WIRING SCHEDULE FOR WIRE
- RE: E6.1 OR PANELBOARD SCHEDULES
- RE: E6.2 FOR LIGHT FIXTURE SCHEDULE.
- RE: E6.2 FOR MECHANICAL / ELECTRICAL SCHEDULE.
- LIGHTING CONTROLS TO INCLUDE "DAYLIGHTING
- ZONE" REQUIREMENTS.
- PROVIDE ADDITIONAL CONDUCTOR WITHIN CIRCUITS WHERE REQUIRED FOR FOR UNSWITCHED POWER TO EXIT SIGNS AND EMERGENCY BALLAST / DRIVER SYSTEMS.
- 10. DESIGNATION REPRESENTS: (E) EXISTING ELECTRICAL DEVICE TO REMAIN AS IS.
- (R) EXISTING ELECTRICAL DEVICE TO TO BE REMOVED IN ITS ENTIRETY.
- (RR) REMOVE AND RELOCATED EXISTING ELECTRICAL
- (NL) NEW LOCATION FOR EXISTING RELOCATED ELECTRICAL DEVICE.
- CCT EXISTING LIGHTING BRANCH CIRCUITING TO BE RE-USED FOR NEW LIGHT FIXTURES.

NOTES BY SYMBOL " (#)"

- (1) EXISTING PANEL IS NOT LABELED. FOR DRAWING PURPOSES THIS EXISTING PANEL WILL BE IDENTIFIED
- (2) EXISTING PANEL IS NOT LABELED. FOR DRAWING PURPOSES THIS EXISTING PANEL WILL BE IDENTIFIED
- NO ELECTRICAL WORK REQUIRED IN THIS ROOM. MAINTAIN LIGHTING AND POWER BRANCHING CIRCUITING CONTINUITY. EXISTING SWITCH TO REMAIN AS IS AND MAINTAIN SWITCHING CONFIGURATION. UNLESS NOTED OTHERWISE.
- (4) CONTRACTOR TO TRACE ALL EXISTING LIGHTING AND BRANCH CIRCUITING TO DETERMINE WHICH CIRCUIT WILL BE RE-USED AND WHICH WILL BECOME "SPARES". PROVIDE NEW UPDATED PANELBOARD DIRECTORIES ONCE RENOVATION IS COMPLETED.
- (5) EXISTING EXTERIOR RECEPTACLES LOCATED ON THE EXISTING EXTERIOR WALLS ARE TO REMAIN AS IS. MAINTAIN EXISTING POWER BRANCH CIRCUITING.
- (6) EXISTING LIGHT FIXTURES DESIGNATED WITH (R) LTG WITHIN THE IS DASHED AREA ARE TO BE DISCONNECTED AND REMOVED IN ITS ENTIRETY. TURN LIGHT FIXTURES OVER TO THE OWNER FOR THEIR DISPOSAL.
- (7) EXISTING LIGHTING BRANCH CIRCUITING DESIGNATED WITH (E) CCT WITHIN THE DASHED AREA IS TO REMAIN AS IS. MAKE SAFE FOR RE-USE. RE: 1/E2.1 PARTIAL FLOOR - LIGHTING PLAN FOR ADDITIONAL INFORMATION.
- (8) EXISTING INTERIOR RECEPTACLES LOCATED ON THE EXISTING EXTERIOR WALLS ARE TO REMAIN AS IS. MAINTAIN EXISTING POWER BRANCH CIRCUITING.
- (9) EXISTING DATA OUTLETS LOCATED ON THE EXISTING EXTERIOR WALLS ARE TO REMAIN AS IS. MAINTAIN EXISTING COMMUNICATION CABLING CONTINUITY.
- (10) EXISTING MECHANICAL UNITS (AHU'S AND CONDENSING UNITS) ARE EXISTING TO REMAIN AS IS UNLESS NOTES OTHERWISE. EXISTING POWER BRANCH CIRCUITING TO REMAIN AS IS AND MAINTAIN EXISTING POWER BRANCH CIRCUITING CONTINUITY.
- (11) EXISTING FIRE ALARM DEVICE(S) LOCATED WITHIN THE DASHED AREA ARE EXISTING TO REMAIN AS IS. EXISTING MAINTAIN FIRE ALARM CONTINUITY BACK TO EXISTING CONTROL PANEL(S). EXISTING FIRE ALARM CONTROL PANEL(S) ARE TO BE DISCONNECTED AND RELOCATED. DISCONNECT AND MAKE SAFE THE EXISTING POWER BRANCH CIRCUITING (FIELD TRACE CCT B-11) TO BE RE-USED. RE: 1/E3.1 PARTIAL FLOOR - POWER AND DATA PLAN FOR ADDITIONAL INFORMATION.
- (12) EXISTING TRACK LIGHTING IS TO BE DISCONNECTED AND RELOCATED. EXISTING LIGHTING BRANCH CIRCUITING TO BE MADE SAFE FOR FUTURE USE. RE: E2.1 PARTIAL FLOOR - LIGHTING PLAN FOR ADDITIONAL INFORMATION.
- (13) EXISTING LIGHT SWITCHES (TOTAL OF 27) ARE TO REMAIN AS IS. MAINTAIN CIRCUITING CONTINUITY AND SWITCHING CONFIGURATION.
- (14) EXISTING CEILING MOUNTED PROJECTOR TO REMAIN AS IS. MAINTAIN CIRCUITING CONTINUITY.
- (15) EXISTING HAND DRYER TO BE DISCONNECTED AND RELOCATED. DISCONNECT AND MAKE SAFE THE EXISTING POWER BRANCH CIRCUITING (FIELD TRACE CCT B-25) TO BE RE-USED. RE: 1/E3.1 PARTIAL FLOOR - POWER AND DATA PLAN FOR ADDITIONAL INFORMATION.

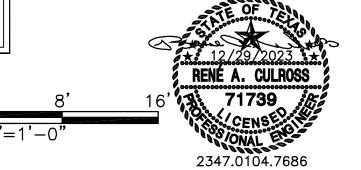

MEP Consultant Rene' A. Culross Rene' A. Culross, P.E., PLLC 1820 Hunting Green Drive Fort Worth, TX 76134 817-798-6642 raculross@gmail.com F-12230

ARCHITECTURE SCOTT MARTSOLF - ARCHITECT

815 Daggett Avenue Fort Worth, Texas 76104

Phone: (817) 820-0005

ST. JUDE CATHOLIC CHURCH


PARISH HALL REMODEL & CONNECTOR BUILDING

> 500 E DALLAS ST. MANSFIELD, TX 76063

12/29/23 ADDENDUM #1	

BID SET

Drawing Title: PARTIAL FLOOR -DEMOLITION PLAN Project No. Date: 12/29/2023 2307 Sheet No.

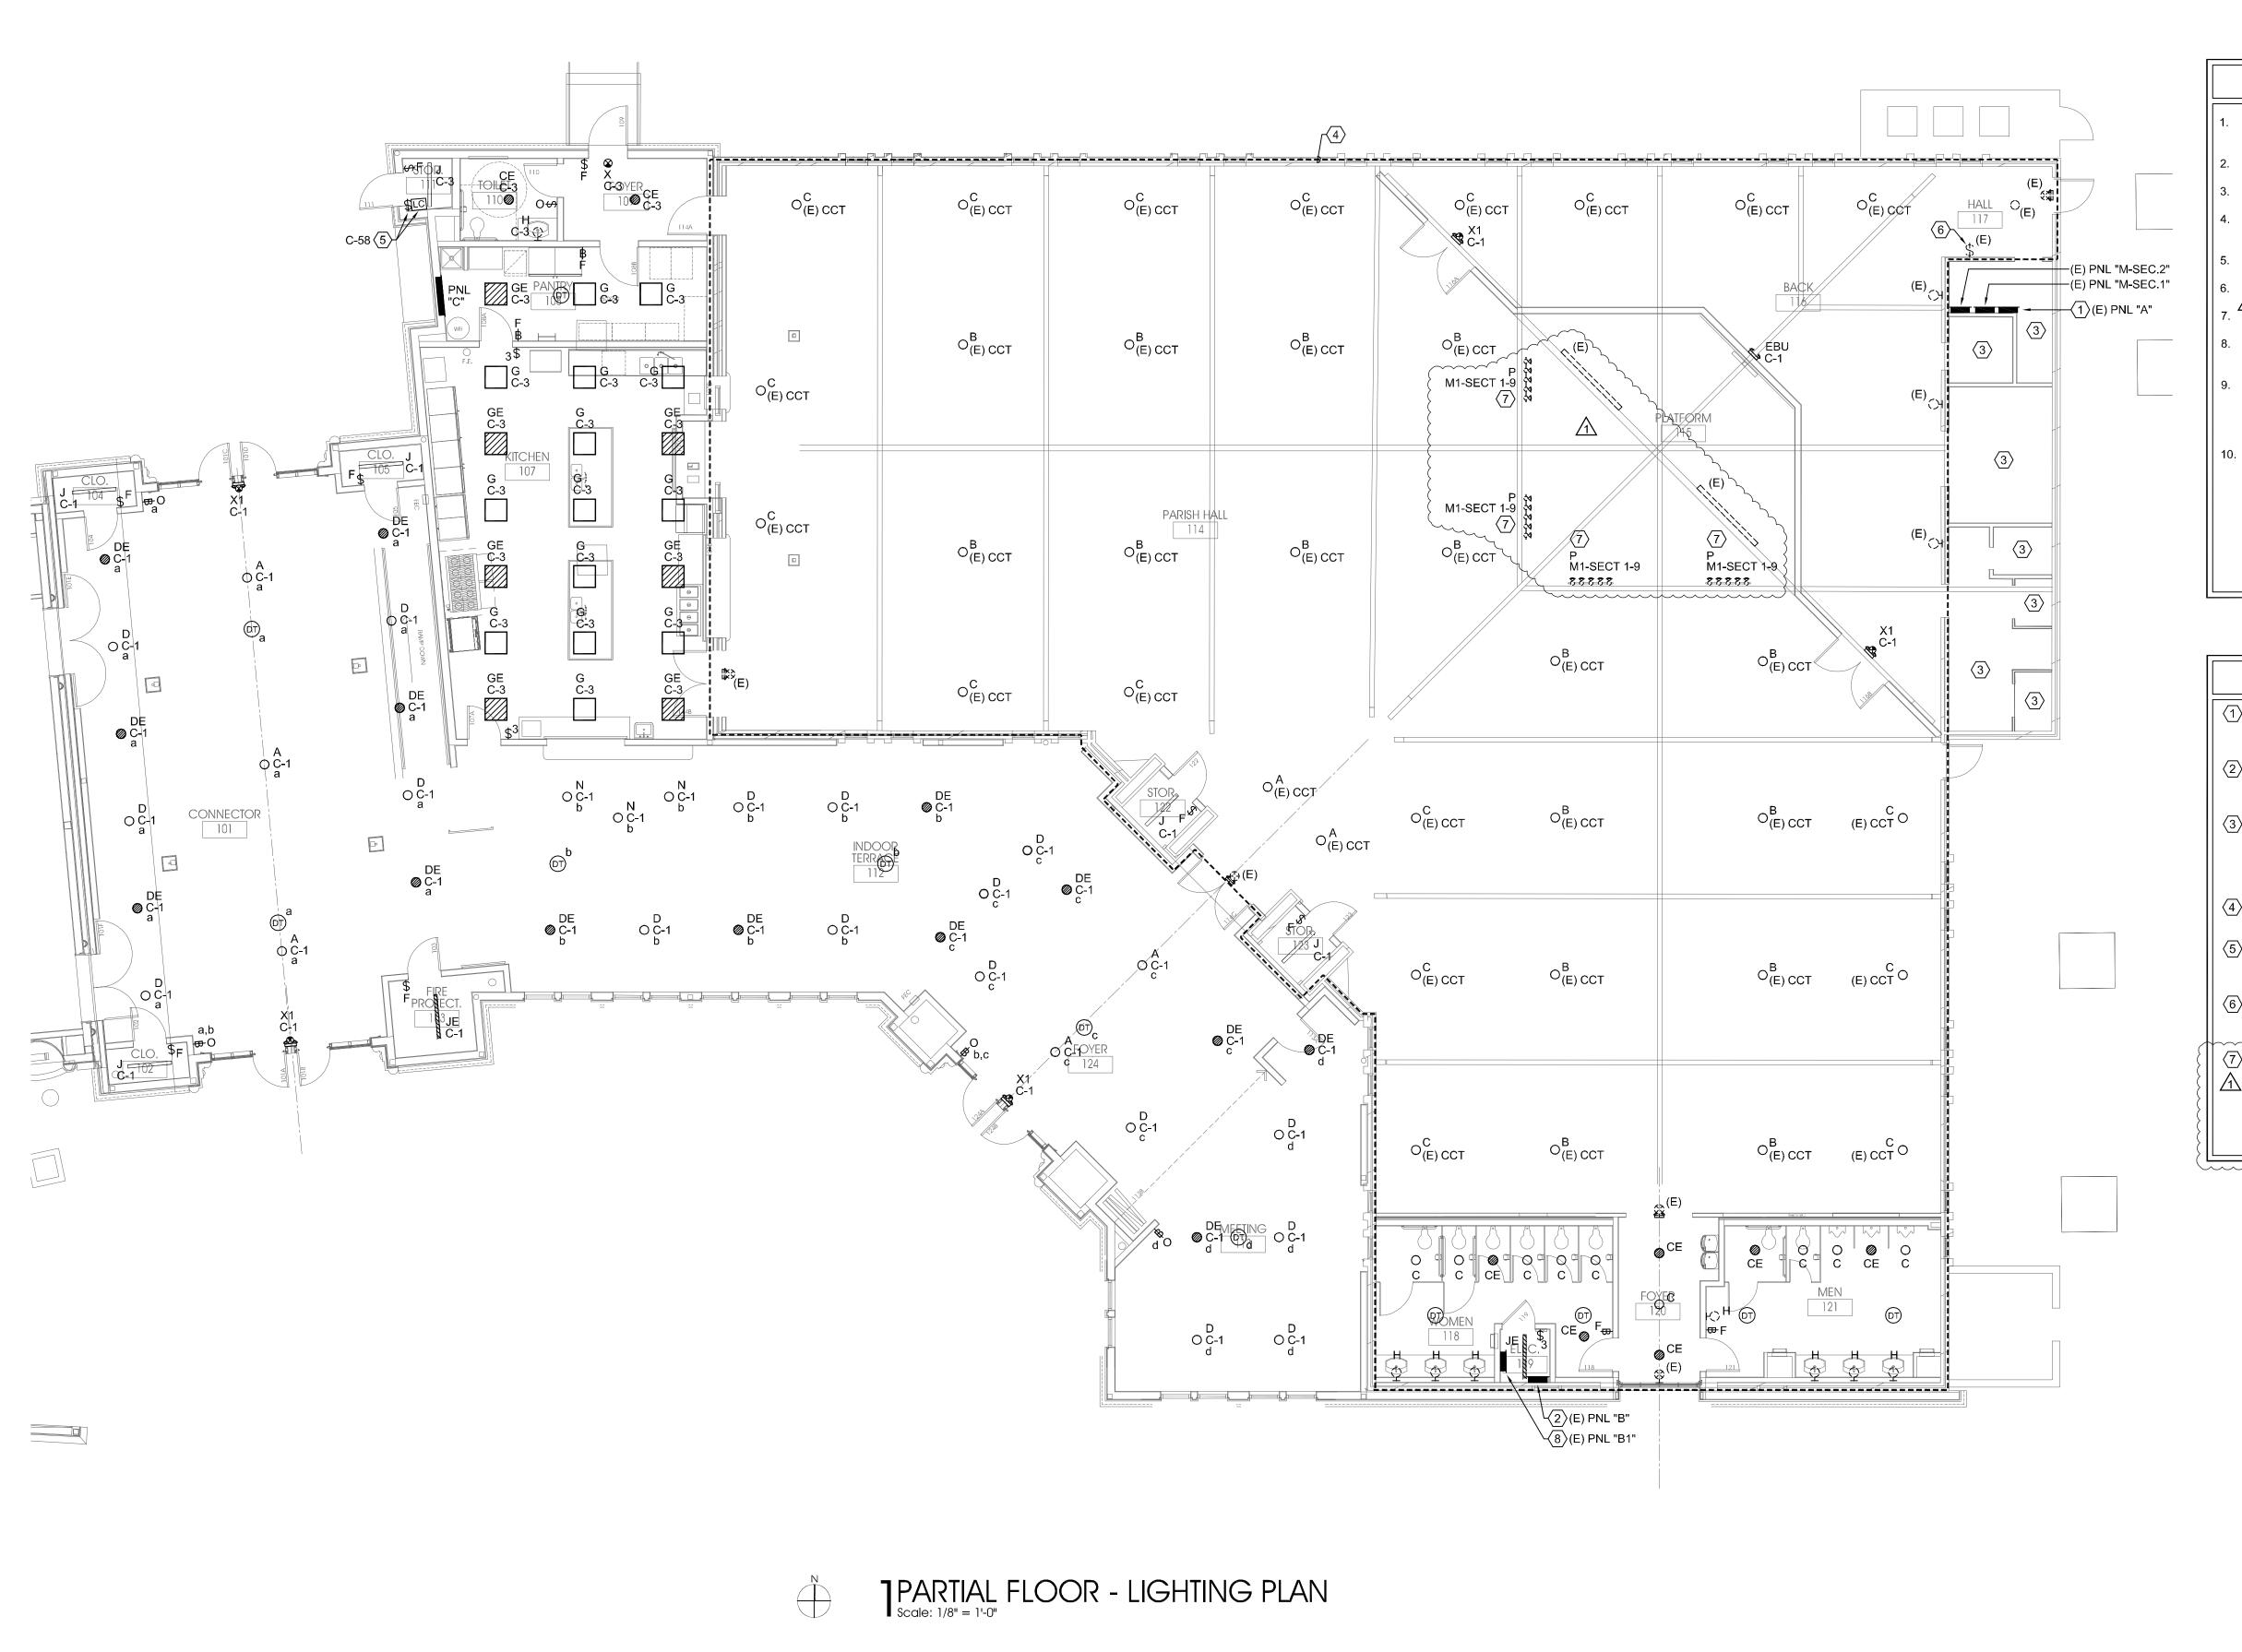

- RE: E0.1 FOR ELECTRICAL SYMBOLS, ADDITIONAL GENERAL NOTES, AND ABBREVIATIONS.
- RE: E0.2 FOR ELECTRICAL SPECIFICATIONS.
- RE: E0.3 FOR LIGHTING CONTROL DETAILS
- RE: E5.1 FOR BRANCH WIRING SCHEDULE FOR WIRE
- RE: E6.1 OR PANELBOARD SCHEDULES.
- RE: E6.2 FOR LIGHT FIXTURE SCHEDULE. $\frac{1}{2}$ RE: E6.2 FOR MECHANICAL / ELECTRICAL SCHEDULE.
- LIGHTING CONTROLS TO INCLUDE "DAYLIGHTING ZONE" REQUIREMENTS.
- PROVIDE ADDITIONAL CONDUCTOR WITHIN CIRCUITS WHERE REQUIRED FOR FOR UNSWITCHED POWER TO EXIT SIGNS AND EMERGENCY BALLAST / DRIVER
- DESIGNATION REPRESENTS:
- (E) EXISTING ELECTRICAL DEVICE TO REMAIN AS IS. (R) EXISTING ELECTRICAL DEVICE TO TO BE
- REMOVED IN ITS ENTIRETY.
 (RR) REMOVE AND RELOCATED EXISTING ELECTRICAL
- (NL) NEW LOCATION FOR EXISTING RELOCATED ELECTRICAL DEVICE.
- CCT EXISTING LIGHTING BRANCH CIRCUITING TO BE RE-USED FOR NEW LIGHT FIXTURES.

NOTES BY SYMBOL " #>"

- EXISTING PANEL IS NOT LABELED. FOR DRAWING PURPOSES THIS EXISTING PANEL WILL BE IDENTIFIED
- 2 EXISTING PANEL IS NOT LABELED. FOR DRAWING PURPOSES THIS EXISTING PANEL WILL BE IDENTIFIED
- NO ELECTRICAL WORK REQUIRED IN THIS ROOM. MAINTAIN LIGHTING AND POWER BRANCHING CIRCUITING CONTINUITY. EXISTING SWITCH TO REMAIN AS IS AND MAINTAIN SWITCHING CONFIGURATION. UNLESS NOTED OTHERWISE
- RE-USE EXISTING LIGHTING BRANCH CIRCUITING TO RE-CONNECT TO NEW LIGHT FIXTURE(S) INDICATED.
- (5) EXTERIOR LIGHTING CONTACTOR AND BY-PASS SWITCH. RE: 1/E0.3 EXTERIOR LIGHTING CONTACTOR WIRING DIAGRAM FOR ADDITIONAL INFORMATION.
- (6) EXISTING LIGHT SWITCHES (TOTAL OF 27) ARE TO REMAIN AS IS. MAINTAIN CIRCUITING CONTINUITY AND SWITCHING CONFIGURATION.
- (7) NEW TRACK LIGHTING. PROVIDE A NEW LIGHTING CIRCUIT AS INDICATED. ROUTE CONDUIT BACK TO EXISTING PANELBOARD "M1-SECT-1" AND EXISTING BANK OF SWITCHES. PROVIDE DIMMER 400 WATT

DIMMERS. PAINT EXPOSED CONDUIT TO MATCH

WOOD CEILING. COORDINATE COLOR WITH THE

ARCHITECTS PRIOR TO PAINTING.

ARCHITECTURE SCOTT MARTSOLF - ARCHITECT


815 Daggett Avenue Fort Worth, Texas 76104

Phone: (817) 820-0005

ST. JUDE CATHOLIC CHURCH

PARISH HALL REMODEL & CONNECTOR BUILDING

500 E DALLAS ST. MANSFIELD, TX 76063

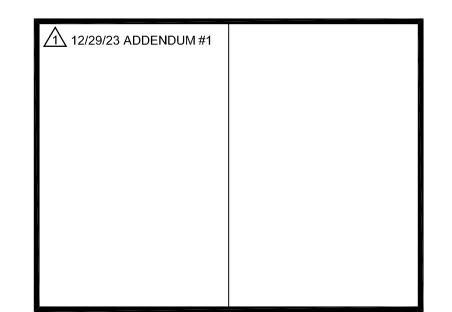


BID SET

Drawing Title: PARTIAL FLOOR -LIGHTING PLAN Project No. Date: 12/29/2023 2307

Sheet No.

MEP Consultant Rene' A. Culross Rene' A. Culross, P.E., PLLC 1820 Hunting Green Drive Fort Worth, TX 76134 817-798-6642 raculross@gmail.com

F-12230

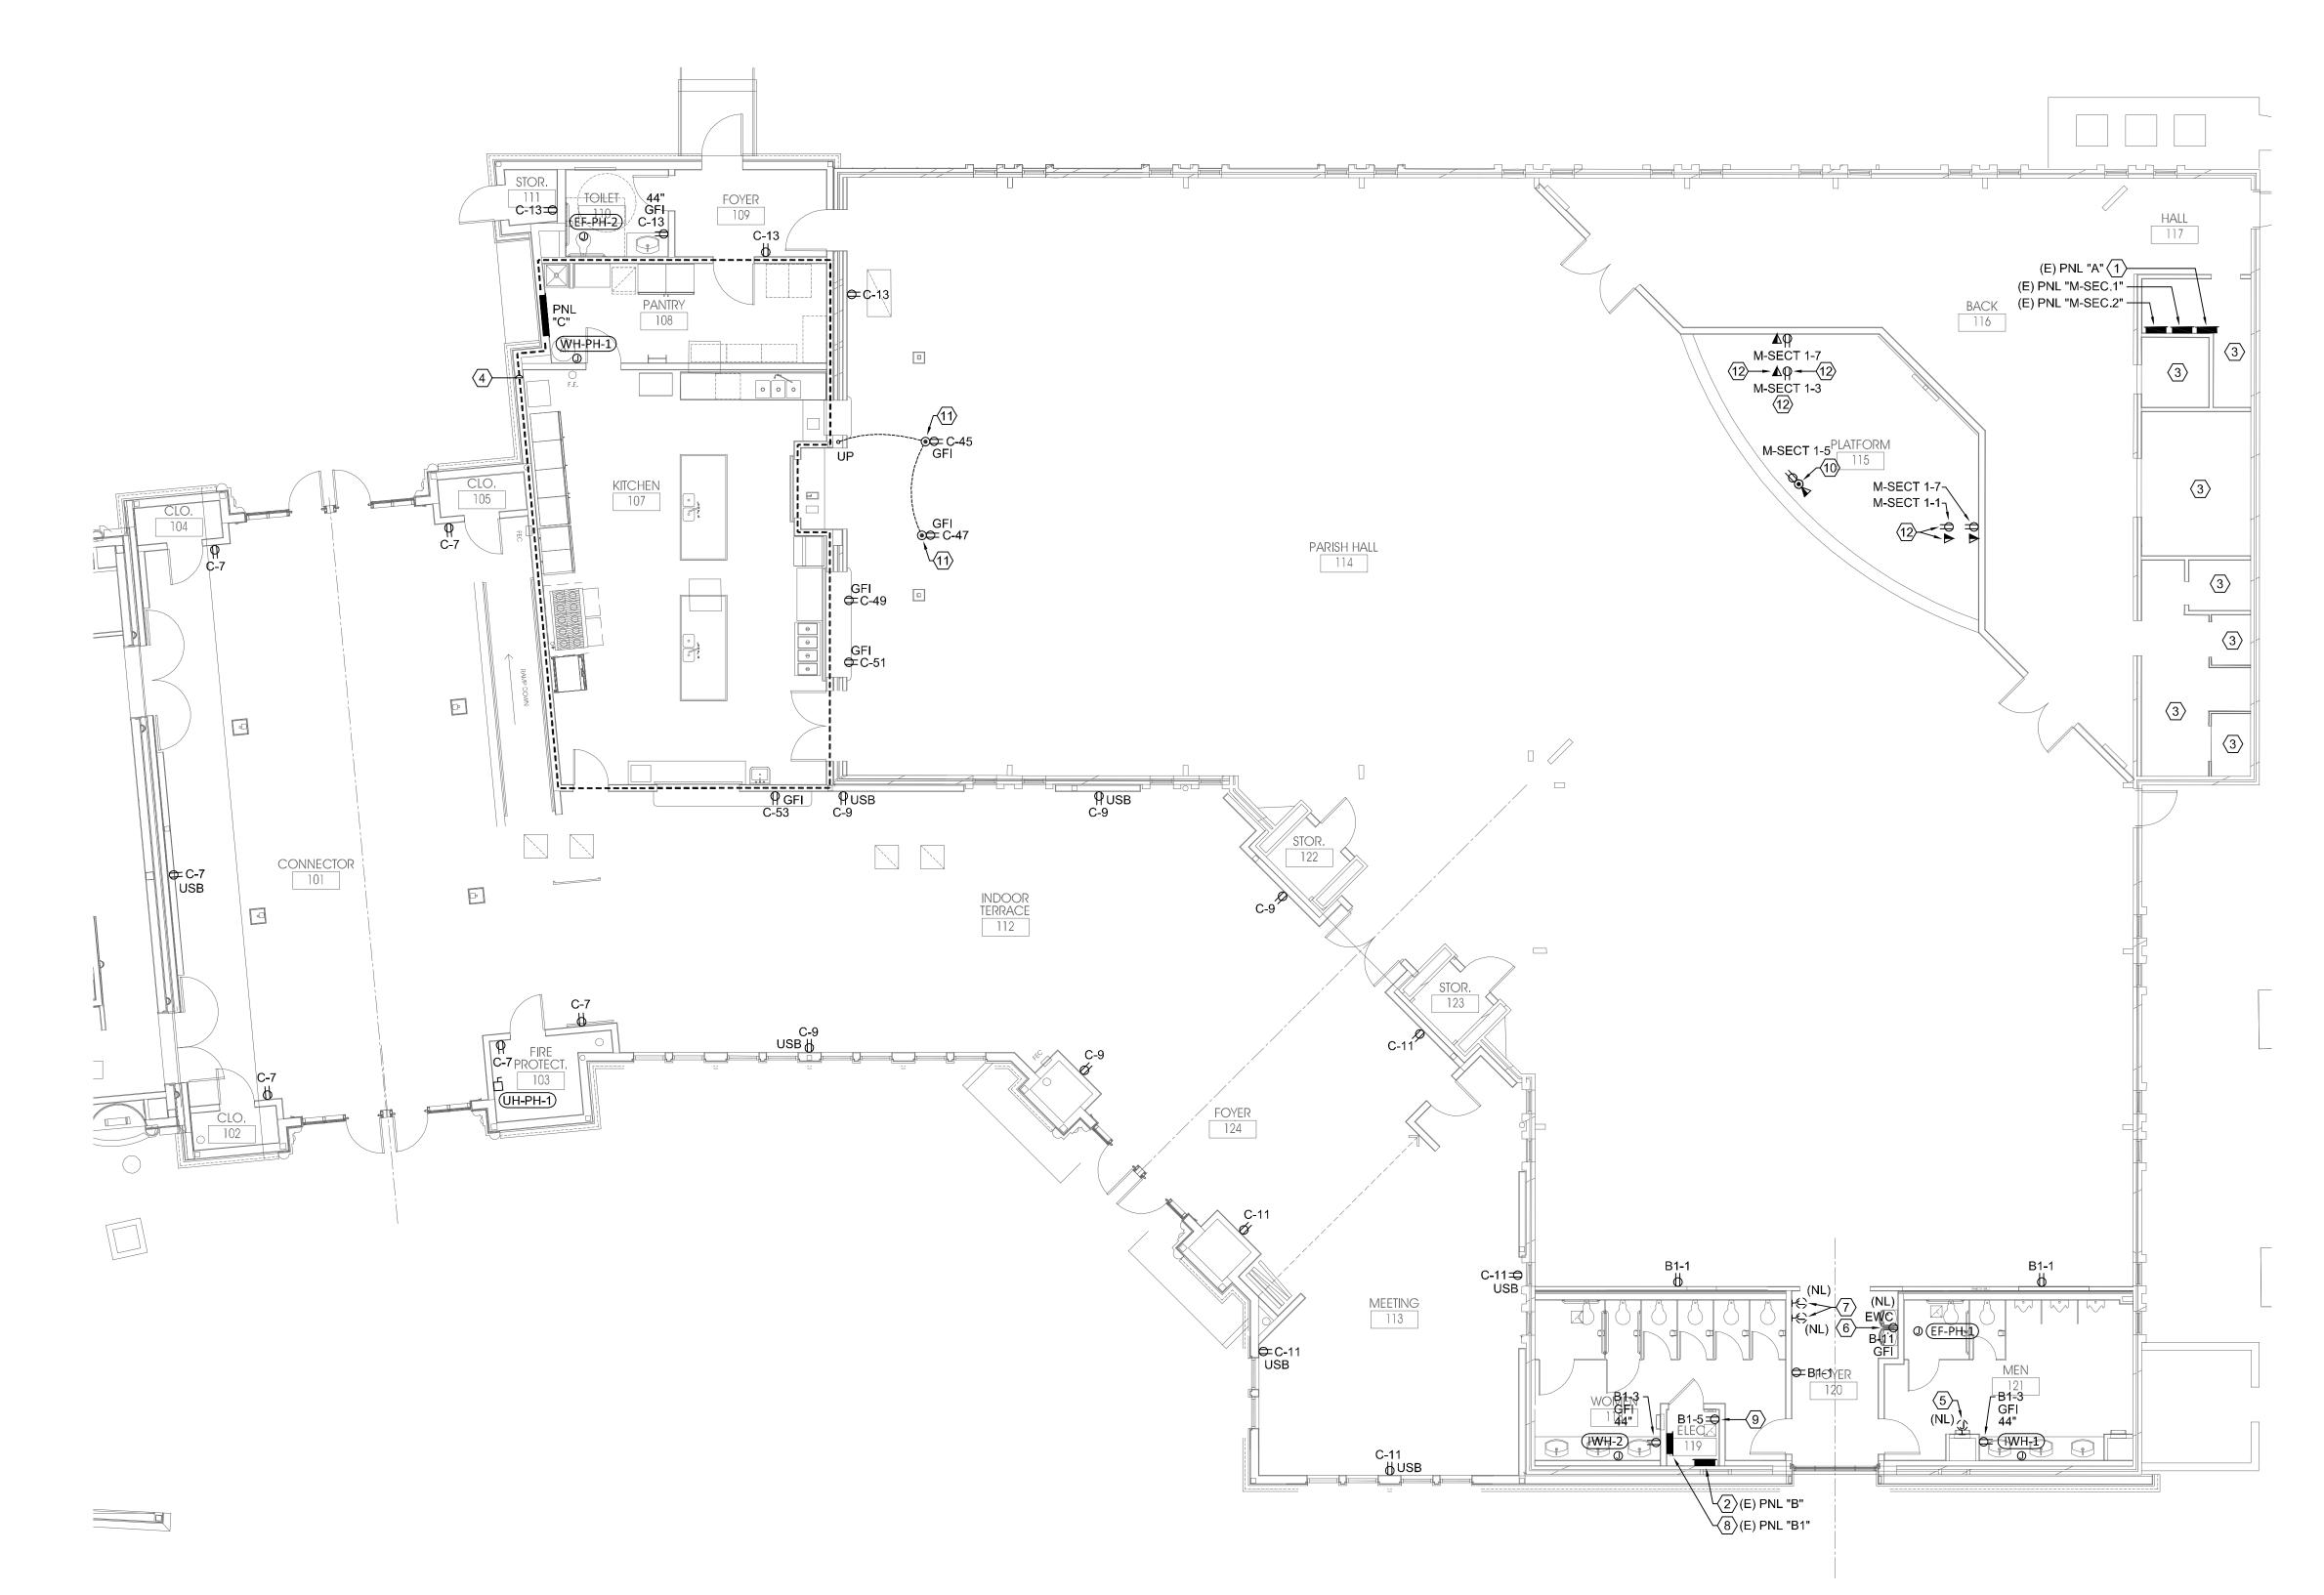

- RE: E0.1 FOR ELECTRICAL SYMBOLS, ADDITIONAL GENERAL NOTES, AND ABBREVIATIONS.
- RE: E0.2 FOR ELECTRICAL SPECIFICATIONS.
- RE: E0.3 FOR LIGHTING CONTROL DETAILS
- RE: E5.1 FOR BRANCH WIRING SCHEDULE FOR WIRE
- RE: E6.1 OR PANELBOARD SCHEDULES.
- RE E7.1 FOR LIGHT FIXTURE SCHEDULE.
- <u>/1\</u> (RE: E7.1 FOR MECHANICAL / ELECTRICAL SCHEDULE.
- LIGHTING CONTROLS TO INCLUDE "DAYLIGHTING ZONE" REQUIREMENTS.
- PROVIDE ADDITIONAL CONDUCTOR WITHIN CIRCUITS WHERE REQUIRED FOR FOR UNSWITCHED POWER TO EXIT SIGNS AND EMERGENCY BALLAST / DRIVER
- DESIGNATION REPRESENTS:
- (X) EXISTING ELECTRICAL DEVICE TO REMAIN AS IS. (R) EXISTING ELECTRICAL DEVICE TO TO BE
- REMOVED IN ITS ENTIRETY.
 (RR) REMOVE AND RELOCATED EXISTING ELECTRICAL
- (NL) NEW LOCATION FOR EXISTING RELOCATED
- ELECTRICAL DEVICE.
 CCT EXISTING LIGHTING BRANCH CIRCUITING TO BE RE-USED FOR NEW LIGHT FIXTURES.

NOTES BY SYMBOL "#"

- EXISTING PANEL IS NOT LABELED. FOR DRAWING PURPOSES THIS EXISTING PANEL WILL BE IDENTIFIED
- (2) EXISTING PANEL IS NOT LABELED. FOR DRAWING PURPOSES THIS EXISTING PANEL WILL BE IDENTIFIED
- (3) NO ELECTRICAL WORK REQUIRED IN THIS ROOM. MAINTAIN LIGHTING AND POWER BRANCHING CIRCUITING CONTINUITY. EXISTING SWITCH TO REMAIN AS IS AND MAINTAIN SWITCHING CONFIGURATION. UNLESS NOTED OTHERWISE
- RE: 1/E4.01 ENLARGED KITCHEN ELECTRICAL PLAN FOR ADDITIONAL INFORMATION.
- 5 EXTEND EXISTING POWER BRANCH CIRCUITING (B-25)
 TO THE EXISTING RELOCATED HAND DRYER.
 MAINTAIN CIRCUITING CONTINUITY.
- (6) EXTEND EXISTING POWER BRANCH CIRCUITING (B-11) TO THE EXISTING RELOCATED HAND DRYER. MAINTAIN CIRCUITING CONTINUITY.
- (7) NEW LOCATION OF EXISTING RELOCATED FIRE ALARM DEVICE(S). EXTEND EXISTING FIRE ALARM CONDUITS AND ASSOCIATED CABLING TO RE-CONNECT TO EXISTING FIRE ALARM PANEL(S). EXISTING MAINTAIN FIRE ALARM CONTINUITY. EXTEND EXISTING POWER BRANCH CIRCUITING (FIELD TRACE CCT B-11) AND RE-CONNECT TO MAINTAIN POWER CONTINUITY.
- (8) NEW PANEL "B1". FIELD VERIFY WALL SPACE TO MOUNT NEW PANEL. RE: 1/E5.1 ELECTRICAL RISER DIAGRAM FOR ADDITIONAL INFORMATION.
- 9 PROVIDE A RECEPTACLE FOR DIVISION 23 TIME CLOCK TO CONTROL EXHAUST FAN "EF-HP-1". COORDINATE WITH DIVISION 23 FOR LOCATION PRIOR TO INSTALLATION.
- (10) PROVIDE A WIREMOLD # RC7ATCAL MULTI-SERVICE POKE-THRU ASSEMBLY OR EQUIVALENT. PROVIDE (2) TWO 3/4" CONDUITS FOR POWER AND DATA CABLES. COORDINATE EXACT LOCATION OF POKE-THRU WITH THE ARCHITECT PRIOR TO INSTALLATION.
- (11) PROVIDE A WIREMOLD # 881 RACHET-PRO SERIES ROUND NONMETALLIC FLOOR OUTLET OR EQUIVALENT. PROVIDE (1) ONE 3/4" CONDUIT FOR POWER CONDUCTORS. COORDINATE EXACT LOCATION OF FLOOR OUTLET WITH THE ARCHITECT PRIOR TO INSTALLATION.
- (12) COORDINATE MOUNTING HEIGHT OF THE MONITOR RECEPTACLE AND DATA OUTLET WITH THE OWNER PRIOR TO INSTALLATION.

MEP Consultant

Fort Worth, TX 76134 817-798-6642 raculross@gmail.com F-12230

ARCHITECTURE SCOTT MARTSOLF - ARCHITECT

815 Daggett Avenue Fort Worth, Texas 76104

Phone: (817) 820-0005

ST. JUDE CATHOLIC CHURCH

PARISH HALL REMODEL & CONNECTOR BUILDING


500 E DALLAS ST. MANSFIELD, TX 76063


12/29/23 ADDENDUM #1

BID SET

Drawing Title: PARTIAL FLOOR -POWER & DATA PLAN Project No. Date: 12/29/2023 2307 Sheet No.

PARTIAL FLOOR - POWER & DATA PLAN

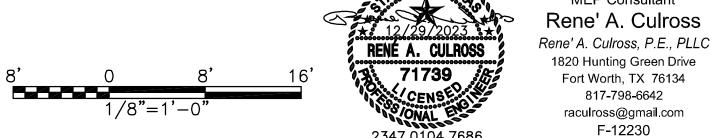

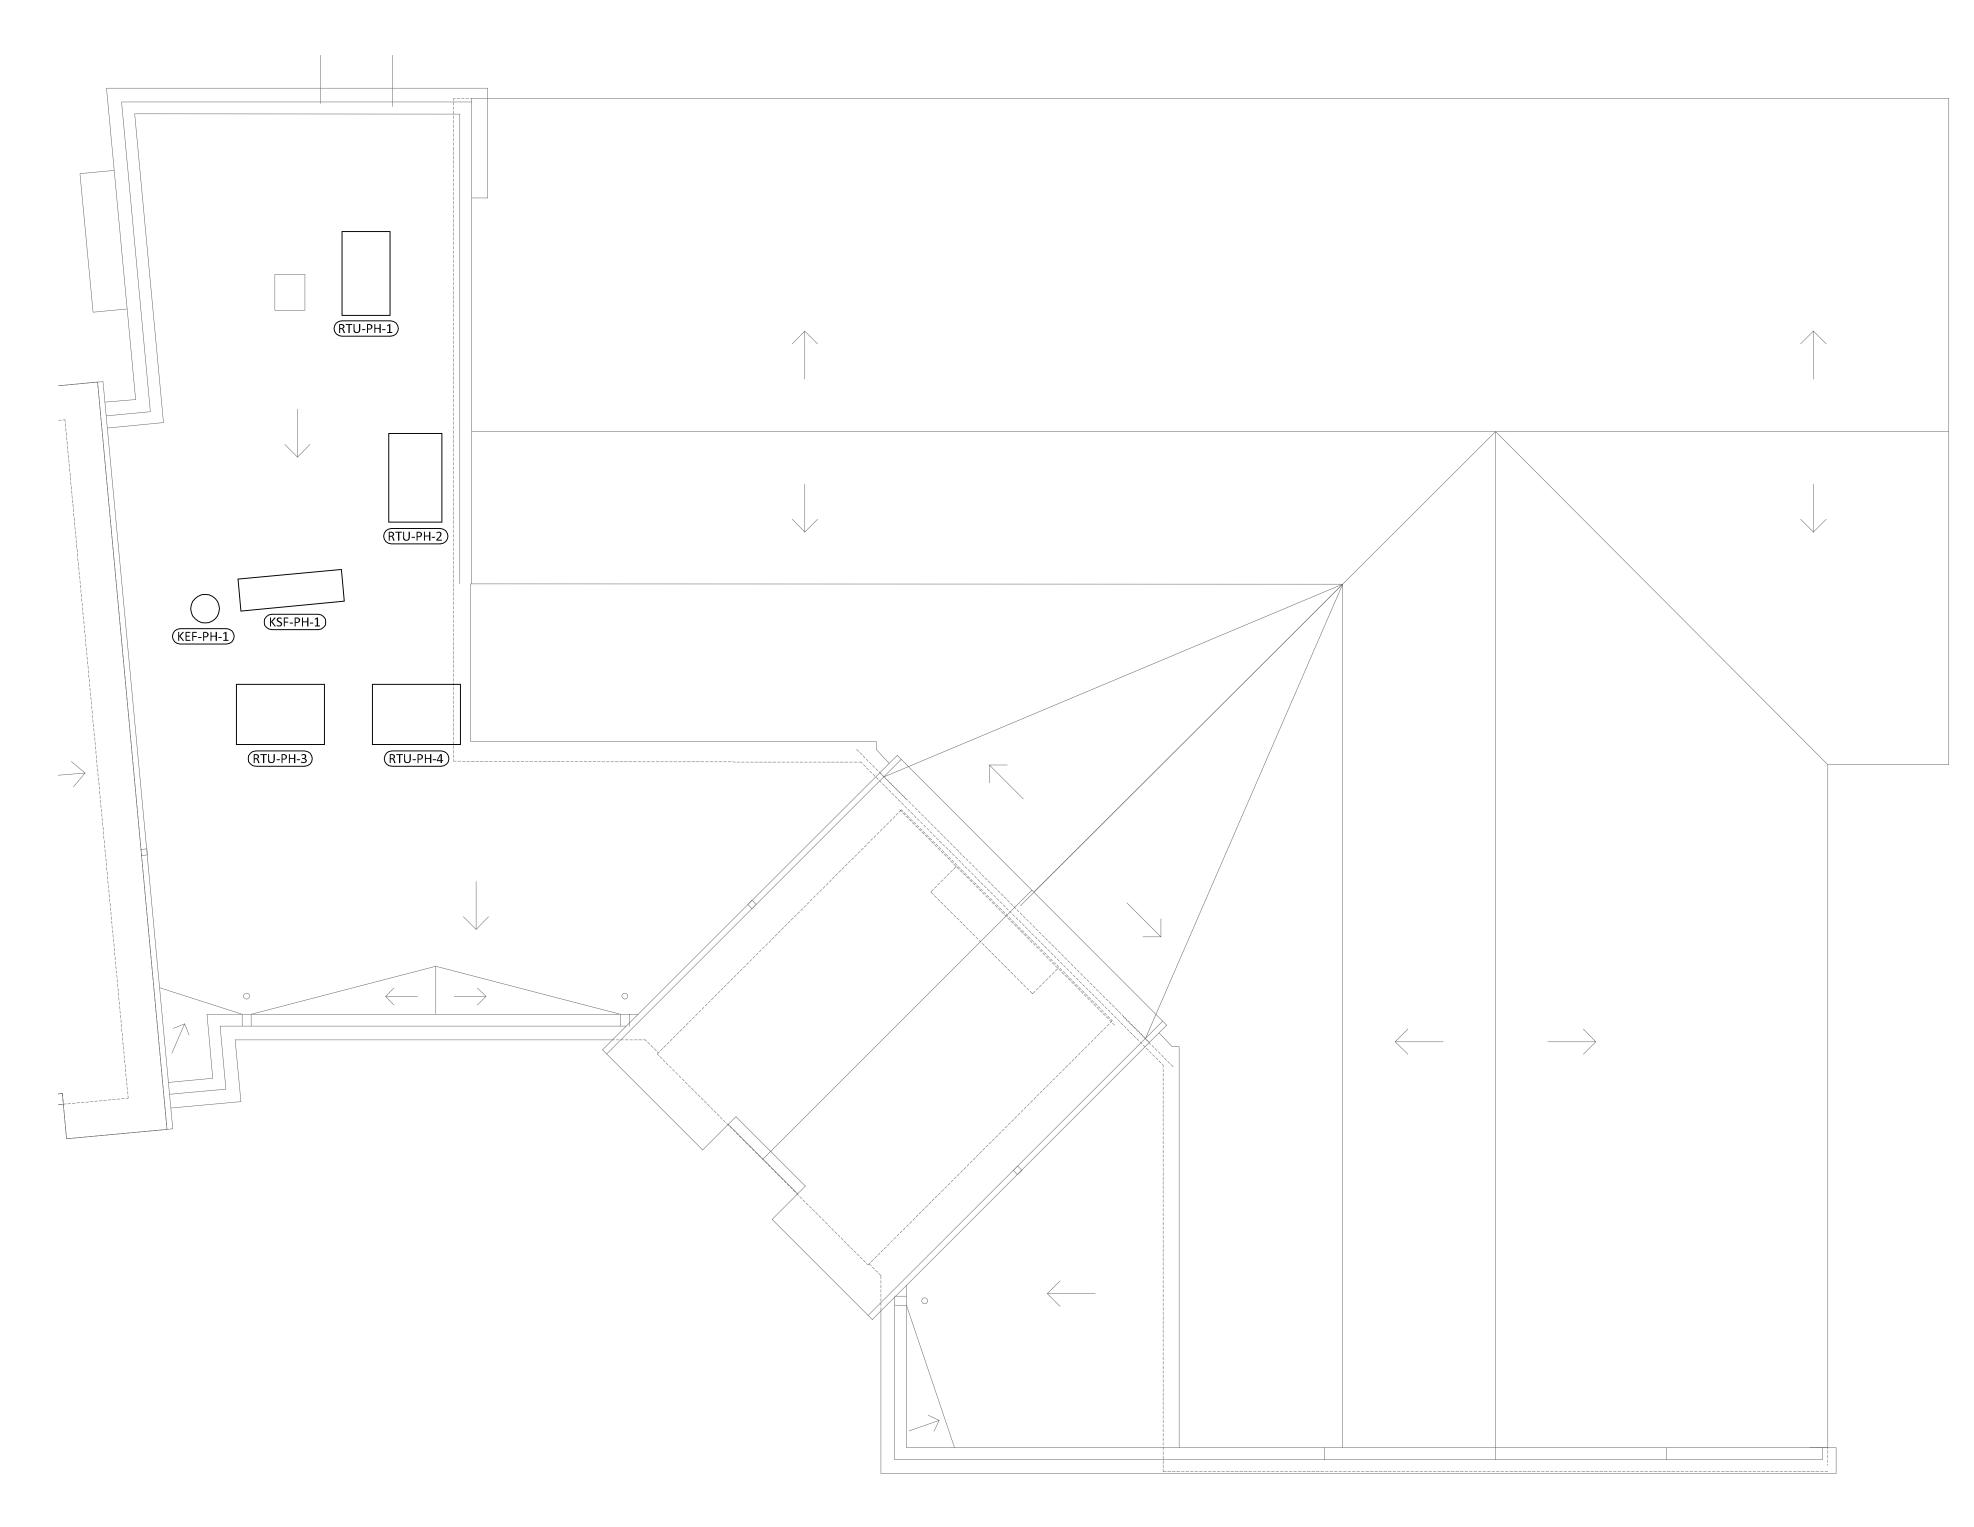

ROOF - ELECTRICAL PLAN

- RE: E0.1 FOR ELECTRICAL SYMBOLS, ADDITIONAL GENERAL NOTES, AND ABBREVIATIONS.
- RE: E0.2 FOR ELECTRICAL SPECIFICATIONS.
- 3. RE: E0.3 FOR LIGHTING CONTROL DETAILS
- 4. RE: E5.1 FOR BRANCH WIRING SCHEDULE FOR WIRE
- RE: E6.1 OR PANELBOARD SCHEDULES.
- RE: E6.2 FOR LIGHT FIXTURE SCHEDULE.
- 7. RE: E6.2 FOR MECHANICAL / ELECTRICAL SCHEDULE.
- LIGHTING CONTROLS TO INCLUDE "DAYLIGHTING ZONE" REQUIREMENTS.
- PROVIDE ADDITIONAL CONDUCTOR WITHIN CIRCUITS WHERE REQUIRED FOR FOR UNSWITCHED POWER TO EXIT SIGNS AND EMERGENCY BALLAST / DRIVER
- 10. DESIGNATION REPRESENTS:

- DESIGNATION REPRESENTS:

 (X) EXISTING ELECTRICAL DEVICE TO REMAIN AS IS.
 (R) EXISTING ELECTRICAL DEVICE TO TO BE REMOVED IN ITS ENTIRETY.
 (RR) REMOVE AND RELOCATED EXISTING ELECTRICAL DEVICE.
 (NL) NEW LOCATION FOR EXISTING RELOCATED ELECTRICAL DEVICE.

 CCT EXISTING LIGHTING BRANCH CIRCUITING TO BE RE-USED FOR NEW LIGHT FIXTURES.

ARCHITECTURE SCOTT MARTSOLF - ARCHITECT


815 Daggett Avenue Fort Worth, Texas 76104

Phone: (817) 820-0005

ST. JUDE CATHOLIC CHURCH

PARISH HALL REMODEL & CONNECTOR BUILDING


> 500 E DALLAS ST. MANSFIELD, TX 76063

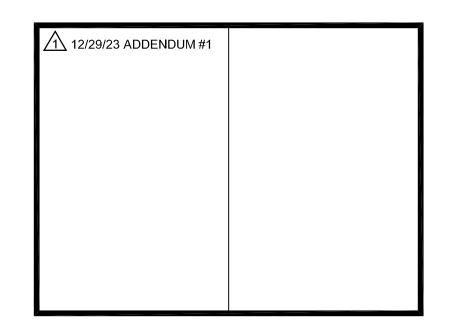

BID SET

Drawing Title:	
ROOF - ELEC PLA	· · · · · · · · · · · · · · · · · · ·
Project No.	Date:
2307	12/29/2023
	Sheet No.

MEP Consultant Rene' A. Culross Rene' A. Culross, P.E., PLLC 1820 Hunting Green Drive Fort Worth, TX 76134 817-798-6642 raculross@gmail.com

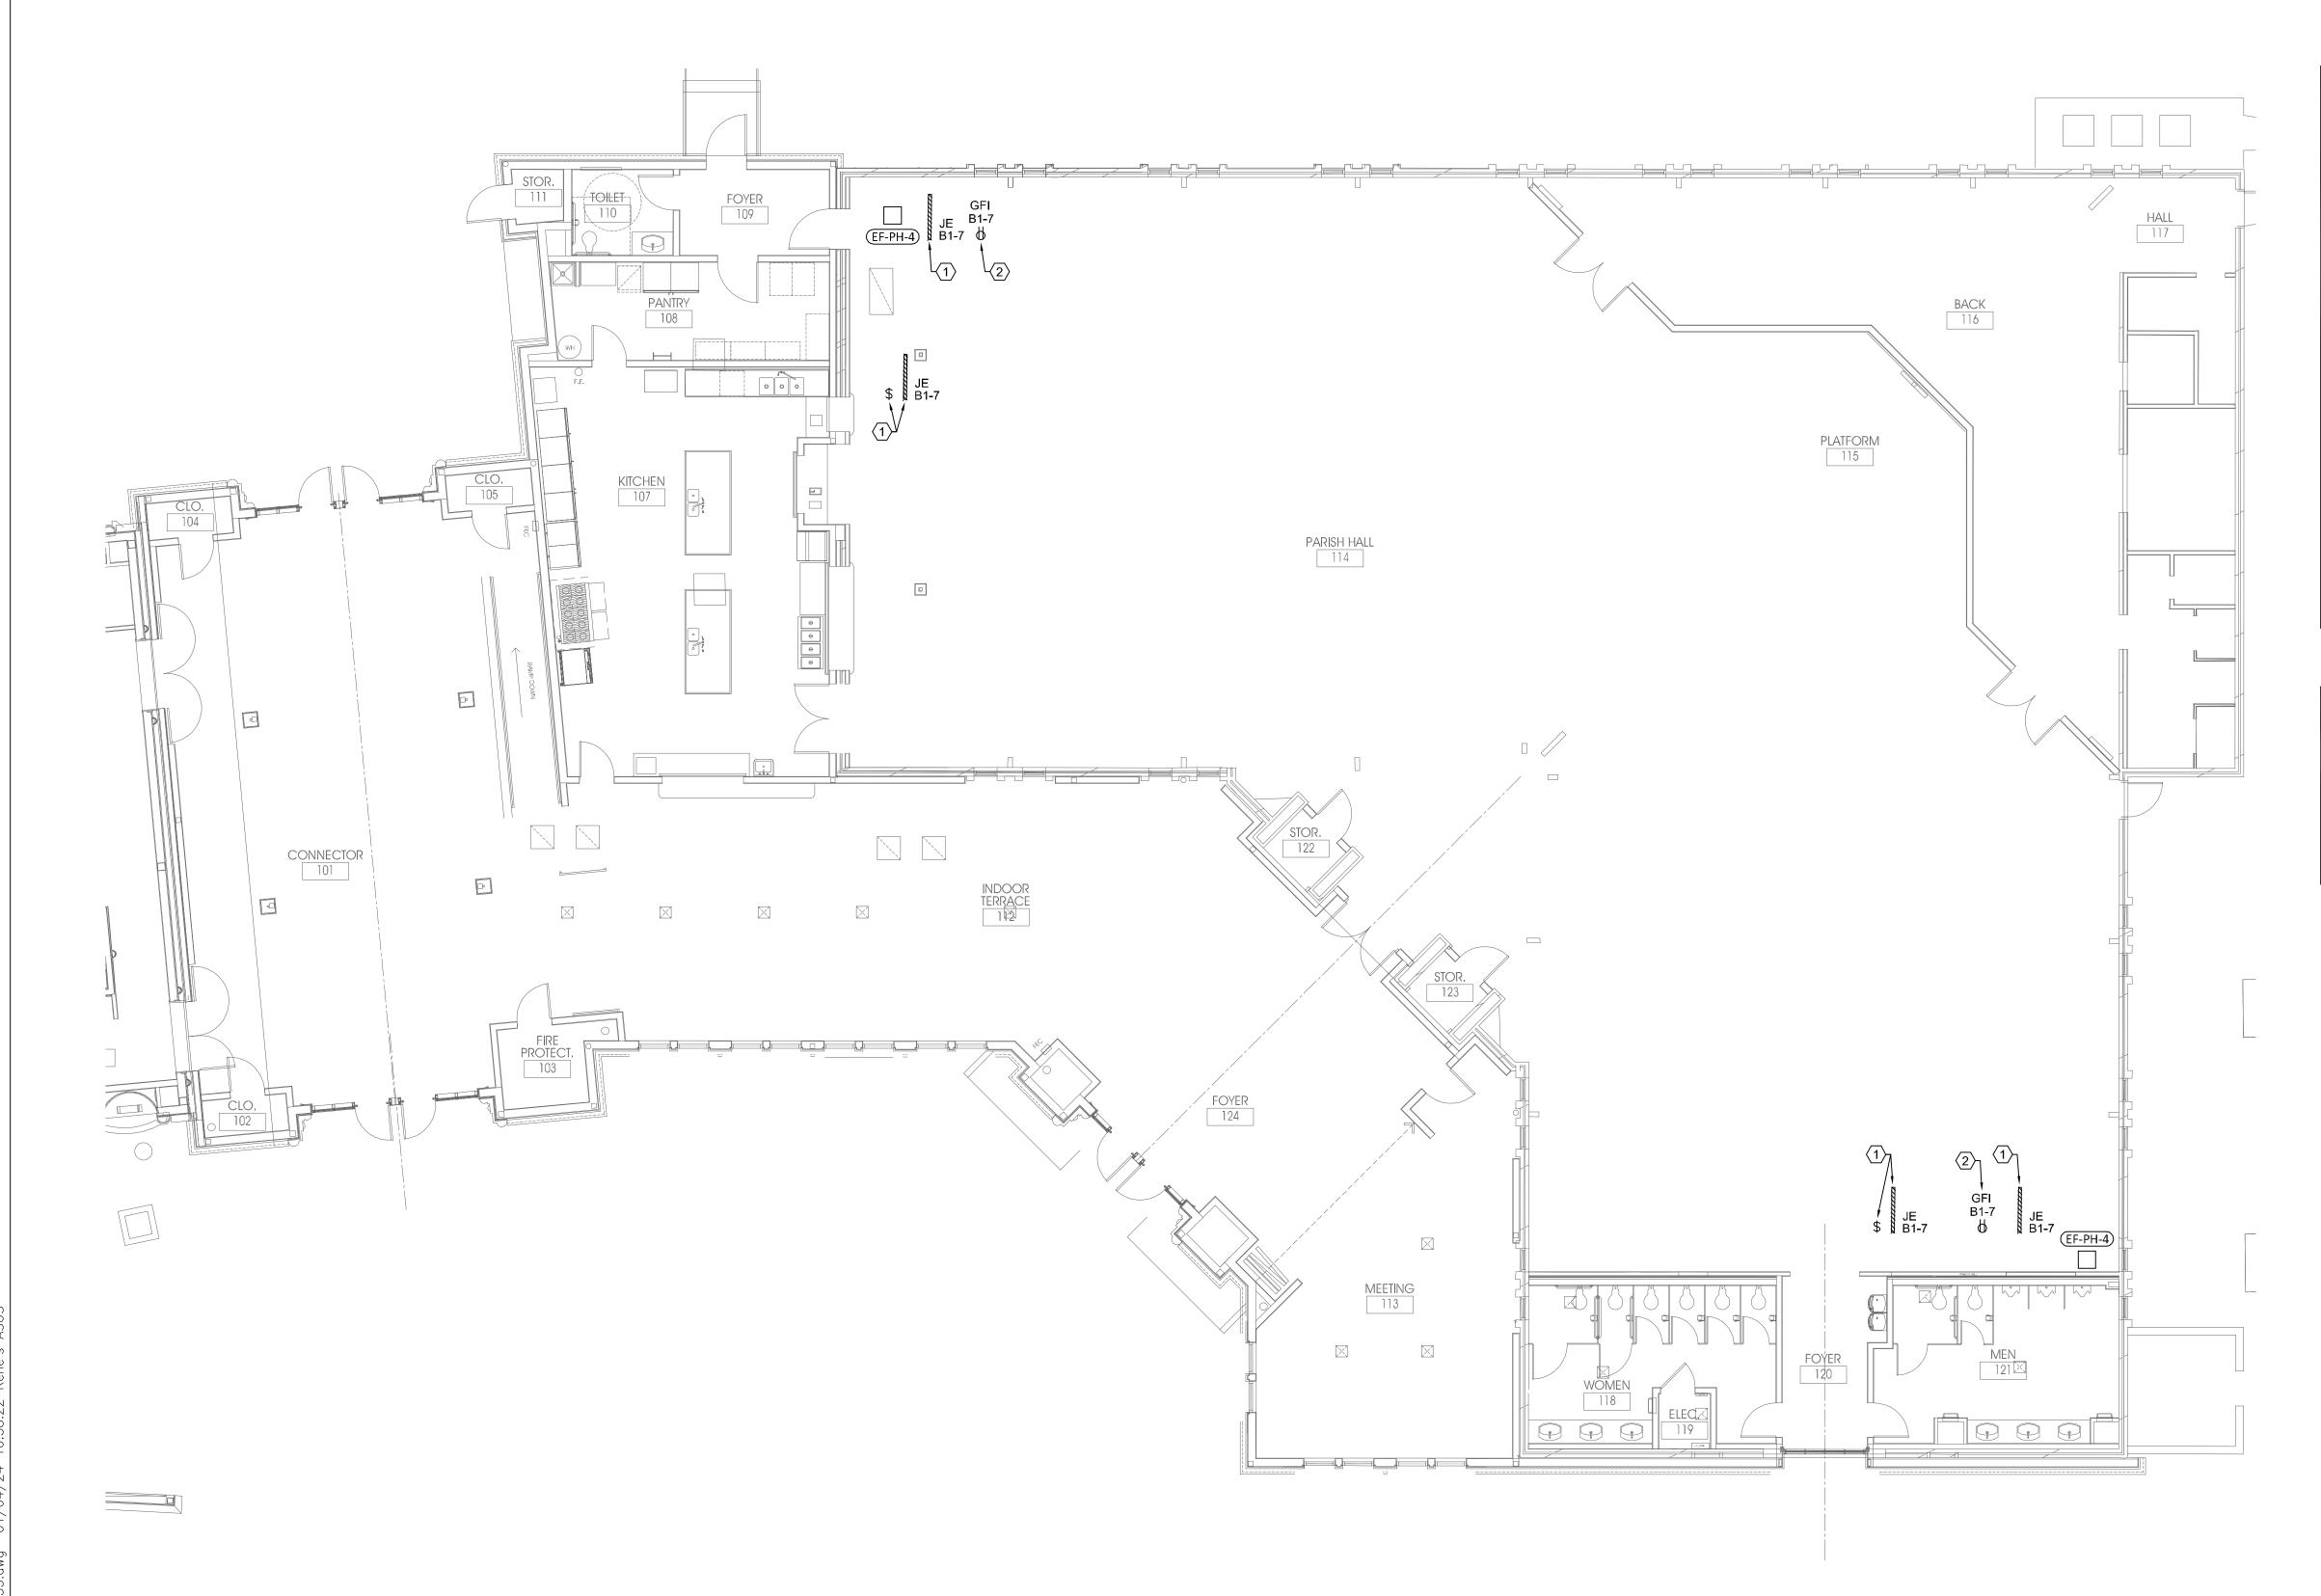

- RE: E0.1 FOR ELECTRICAL SYMBOLS, ADDITIONAL GENERAL NOTES, AND ABBREVIATIONS.
- RE: E0.2 FOR ELECTRICAL SPECIFICATIONS.
- RE: E0.3 FOR LIGHTING CONTROL DETAILS
- RE: E5.1 FOR BRANCH WIRING SCHEDULE FOR WIRE
- RE: E6.1 OR PANELBOARD SCHEDULES.
- RE: E6.2 FOR LIGHT FIXTURE SCHEDULE.
- $\frac{11}{2}$ RE: E6.2 FOR MECHANICAL / ELECTRICAL SCHEDULE.
- LIGHTING CONTROLS TO INCLUDE "DAYLIGHTING ZONE" REQUIREMENTS.
- PROVIDE ADDITIONAL CONDUCTOR WITHIN CIRCUITS WHERE REQUIRED FOR FOR UNSWITCHED POWER TO EXIT SIGNS AND EMERGENCY BALLAST / DRIVER
- DESIGNATION REPRESENTS:
- (X) EXISTING ELECTRICAL DEVICE TO REMAIN AS IS.(R) EXISTING ELECTRICAL DEVICE TO TO BE
- REMOVED IN ITS ENTIRETY.
 (RR) REMOVE AND RELOCATED EXISTING ELECTRICAL
- (NL) NEW LOCATION FOR EXISTING RELOCATED
 ELECTRICAL DEVICE.
 CCT EXISTING LIGHTING BRANCH CIRCUITING TO BE
 RE-USED FOR NEW LIGHT FIXTURES.

NOTES BY SYMBOL " #>"

- MOUNT LIGHT SWITCH ADJACENT TO THE CRAWL SPACE ACCESS DOOR. PROVIDE ANOTHER LIGHT FIXTURE ADJACENT TO THE EXHAUST FAN. FIXTURES TO BE MOUNTED TIGHT TO THE STRUCTURE IF POSSIBLE OR CHAIN HUNG 2" INCHED FROM
- MOUNT RECEPTACLE ADJACENT TO THE EXHAUST FAN. PROVIDE A WEATHERPROOF IN-USE COVER.

ARCHITECTURE SCOTT MARTSOLF - ARCHITECT

815 Daggett Avenue Fort Worth, Texas 76104

Phone: (817) 820-0005

ST. JUDE CATHOLIC CHURCH

PARISH HALL REMODEL & CONNECTOR BUILDING

500 E DALLAS ST. MANSFIELD, TX 76063

12/29/23 ADDENDUM #1

BID SET

Drawing Title: PARTIAL CRAWL SPACE -POWER & DATA PLAN Project No. Date:

2307

MEP Consultant


817-798-6642 raculross@gmail.com F-12230

12/29/2023

Sheet No.

E3.3

PARTIAL CRAWL SPACE - POWER PLAN

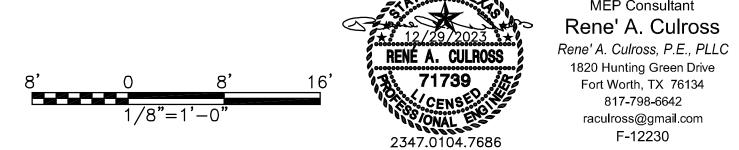

	L "B" N: ELECTRICAL R M: PANEL "M"	COOM		CE TYPE: BRE FAMILY: BOLT				ENCLOS MOUNTI VOLTAG	NG: SUR	FACE		`): 225 MLO 3-PHASE 4-WIRE	CONTINUOUS(A): 225 BUS SC RATING(A) MATCH FAULT CURRENT(A): MATCH		
OC MPS P	NOTES	DESCRIPTION		DEMAND CODE	VA	СКТ	PHASE A	E LOAD B	S VA C	СКТ	VA	DEMAND CODE	DESCRIPTION	NOTES	OC AMPS P	
20 3	NOTE 1	(E) LOADS		GEN	0	1	0			2	0	GEN	(E) LOADS	NOTE 1	20 3	
_	-	-		-	0	3		0		4	0	-	-	-	_	
_	_	_		-	0	5			0	6	0	-	-	-	-	
30 2	NOTE 1	(E) LOADS		GEN	0	7	0			8	0	GEN	(E) LOADS	NOTE 1	20 1	
-	-	-		-	0	9		0		10	0	GEN	(E) LOADS	NOTE 1	20 1	
20 1	NOTE 1	(E) LOADS		GEN	0	11			0	12	0	GEN	(E) LOADS	NOTE 1	20 1	
20 1	NOTE 1	(E) LOADS		GEN	0	13	0			14	0	GEN	(E) LOADS	NOTE 1	20 1	
20 1	NOTE 1	(E) LOADS		GEN	0	15		0		16	0	GEN	(E) LOADS	NOTE 1	20 1	
20 1	NOTE 1	(E) LOADS		GEN	0	17			0	18	0	GEN	(E) LOADS	NOTE 1	20 1	
20 1	NOTE 1	(E) LOADS		GEN	0	19	0			20	0	GEN	(E) LOADS	NOTE 1	20 1	
20 1	NOTE 1	(E) LOADS (F.A.C	.P)	GEN	0	21		0		22	0	GEN	(E) LOADS	NOTE 1	20 1	
20 1	NOTE 1	(E) LOADS		GEN	0	23			0	24	0	GEN	(E) LOADS	NOTE 1	20 2	
30 1	NOTE 1	(E) LOADS		GEN	0	25	0			26	0	_		-	_	
30 2	NOTE 1	(E) LOADS		GEN	0	27		0		28	0	GEN	(E) LOADS	NOTE 1	30 1	
_	_			_	0	29			0	30	0	GEN	(E) LOADS	NOTE 1	30 1	
20 1	NOTE 1	(E) LOADS		GEN	0	31	0			32	0	GEN	(E) LOADS	NOTE 1	30 1	
20 1	NOTE 1	(E) LOADS		GEN	0	33		0		34	0	GEN	(E) LOADS	NOTE 1	30 1	
30 1	NOTE 1	(E) LOADS		GEN	0	35			0	36	0	GEN	(E) LOADS	NOTE 1	30 1	
30 1	NOTE 1	(E) LOADS		GEN	0	37	0			38	4100	GEN	NEW PANEL "B1"	NOTES 2,3,4	60 3	
30 1	NOTE 1	(E) LOADS		GEN	0	39		0		40	2140	_	-	-	_	
- 1	-	(E) BLANK		BLK	0	41			0	42	2700	-	-	-	-	
ALL C	CONNECTED	KVA	MAX AMPS	1	* PH	ASE TO	ΓALS	VA		AMP	S	-		BUS TOTALS	KVA	
TOTA	L CONNECTED	8.94	24.8		* A-N	1		4100.0)	34.2				CONNECTED	8.94	
TOTA	L DEMAND	8.94	24.8		* B-N	1		2140.0)	17.8	}			DEMAND	8.94	
TOTA	L DESIGN	8.94	24.8		* C-N	1		2700.0)	22.5	,			DESIGN	8.94	

	NEL "B1" N: ELECTRICAL R M: (E) PANEL "B"	ROOM		CE TYPE: BRE FAMILY: BOLT			1	MOUNTI	URE: NE NG: SUF E: 208/	RFACE		•	x): 60 MLO 3-PHASE 4-WIRE	CONTINUOUS(A) BUS SC RATING(FAULT CURRENT	A) MATCH
OC AMPS P	NOTES	DESCRIPTION		DEMAND CODE	VA	CKT	PHASE A	LOAD B	S VA C	CKT	VA	DEMAND CODE	DESCRIPTION	NOTES	OC AMPS P
20 1	-	INTERIOR RECEPT	TACLES	REC	540	1	2140			2	3000	GEN	IWH-1	-	25 2
20 1	-	INTERIOR RECEPT	TACLES	REC	500	3		2140		4	_	-	-	-	_
20 1	-	EF-PH-3 - EF-PH-4		MTR	1200	5			2700	6	3000	GEN	IWH-2	<u>-</u>	25 2
20 1	-	CRAWL SPACE - L	TG - REC	LTG	460	7	1960			8	-	_	-	-	_
20 1	_	SPARE		SPR	0	9		0		10	0	SPR	SPARE	<u>-</u>	20 1
20 1	_	SPARE		SPR	0	11			0	12	0	SPR	SPARE	-	20 1
1	_	BLANK		BLK	-	13	0			14	-	BLK	BLANK	-	1
1	_	BLANK		BLK	_	15		0		16	_	BLK	BLANK	-	1
1	_	BLANK		BLK	_	17			0	18	_	BLK	BLANK	-	1
1	-	BLANK		BLK	-	19	0			20	-	BLK	BLANK	-	1
ALL C	CONNECTED	KVA N	IAX AMPS	•	* PH/	SE TO	TALS	VA		AMF	PS	•		BUS TOTALS	KVA
TOTA	AL CONNECTED	8.94	24.8		* A-N			4100.0	0	34.2	2			CONNECTED	8.94
TOTA	AL DEMAND	8.94	24.8		* B-N			2140.0	0	17.8	3			DEMAND	8.94
TOTA	AL DESIGN	8.94	24.8		* C-N			2700.0	0	22.5	5			DESIGN	8.94

PANELBOARD NOTES ONLY

DISCONNECT AND REMOVE EXISTING "BLANK" FILLER TO ALLOW NEW CIRCUIT BREAKER AS INDICATED.


 PROVIDE A NEW CIRCUIT BREAKER AS INDICATED. MATCH EXISTING MANUFACTURER AND AIC RATING.

3. PROVIDE AN UPDATE PANELBOARD SCHEDULE.

LÓCATIO	EL "M1 SECT 1" DN: ELECTRICAL R DM: UTILITY		CE TYPE: BRE FAMILY: BOL1				ENCLOS MOUNTI VOLTAG	NG: SUF	RFACE		•): 600 MLO 3-PHASE 4-WIRE	CONTINUOUS(A): BUS SC RATING(A FAULT CURRENT(A	,
OC AMPS P	NOTES	DESCRIPTION	DEMAND CODE	VA	СКТ	PHASE A	E LOAD B	S VA C	СКТ	VA	DEMAND CODE	DESCRIPTION	NOTES	OC AMPS P
20 1	NOTES 1,2,3	MONITOR RECEPTACLE	REC	600	1	600			2	0	BLANK	(E) BLANK	_	- 1
20 1	NOTES 1,2,3	MONITOR RECEPTACLE	REC	600	3		600		4	0	BLANK	(E) BLANK	_	- 1
20 1	NOTES 1,2,3	PLATFORM RECEPTACLE	REC	1200	5			1200	6	0	BLANK	(E) BLANK	-	- 1
20 1	NOTES 1,2,3	PLATFORM RECEPTACLE	REC	1200	7	1200			8	0	BLANK	(E) BLANK	_	- 1
<u>/1_20_1</u>	NOTES 1,2,3	PLATFORM - TRACK LTG	LTG	1200	79	~~~	1200		10	0	BLANK	(E) BLANK	_	- 1
~ <u>-</u> ~~~	<u>-</u>	(É) BLANK	/ BLANK ^ ^	~~~~	 			0	12	0	BLANK	(E) BLANK	_	- 1
40 3	-	(E) CONDENSING UNIT	COOL	8640	13	0			14	0	BLANK	(E) BLANK	-	- 1
-	-	-	-	_	15		0		16	0	BLANK	(E) BLANK	-	- 1
-	-	-	_	-	17			0	18	0	BLANK	(E) BLANK	-	- 1
40 3	-	(E) LOADS	GEN	8640	19	0			20	8640	GEN	(E) LOADS	-	40 3
-	-] -	_	_	21		0		22	0	_	-	-	_
_	-	-	-	_	23			0	24	0	_	-	-	_
40 3	-	(E) LOADS	GEN	8640	25	0			26	8640	GEN	(E) LOADS		40 3
-	-	-	_	_	27		0		28	0	_	-	-	-
-	-	-	-	_	29			0	30	0	_	-	-	-
40 3	-	(E) LOADS	GEN	8640	31	0			32	8640	GEN	(E) LOADS	-	40 3
-	-	-	-	0	33		0		34	0	-	-	-	-
=	-	-	-	0	35			0	36	0	_	-	-	-
40 3	-	(E) LOADS	GEN	8640	37	0			38	8640	GEN	(E) LOADS	-	40 3
-	-	-	-	0	39 41		0	0	40 42	0	-	-	-	-
-	_	_	<u> </u>	0							_	-		
	CONNECTED	KVA MAX AMPS	·····		ASE TO	ΓALS	VA VA	~~~			~~~~~	~~~~~~	BUS TOTALS	× KVA
	AL CONNECTED	4.8 13.3		* * A-N			1800.0		15.(ČOŇŇĚCŤĚĎ	4.8
	AL DEMAND	4.8 13.3		* B-N * C-N			1800.0		15.0				<u>∕1</u> \ DEMAND DESIGN	4.8
	AL DESIGN	4.8 13.3		- U-IN	 		1200.0		10.0) ~~~~		~~~~~	DESIGN	4.8
NOTE 1. P		EDULES ARE FOR REFERENCE (ONLY. FIELD V	'ERIFICATI	ON AS I	NEEDED .	ТО СОМЕ	PLETE TH	HE REN	OVATIONS	S AND UPDAT	E PANELBOARD DIRE	CTORY.	

LOCATIO	EL "M1 SECT 2" DN: ELECTRICAL R DM: UTILITY	ROOM		CE TYPE: BRE AMILY: BOLT				MOUNT	SURE: NE ING: SUF GE: 208/1	RFACE			A): 600 MLO 3-PHASE 4-WIRE	CONTINUOUS(A): 600 BUS SC RATING(A) MATCH FAULT CURRENT(A): MATCH		
OC AMPS P	NOTES	DESCRIPTION	l	DEMAND CODE	VA	CKT	PHASE A	E LOA B	DS VA C	СКТ	VA	DEMAND CODE	DESCRIPTION	NOTES	OC AMPS	
50 3	-	(E) LOADS		GEN	0	1	0			2	0	GEN	(E) LOADS	-	20	
-	_	_		-	0	3		0		4	0	_		-	_	
-	_	-		-	0	5			0	6	0	_	-	-	-	
20 3	-	(E) LOADS		GEN	0	7	0			8	0	GEN	(E) LOADS	-	20	
-	-	-		-	0	9		0		10	0	_	-	-	_	
-	=	-		-	0	11			0	12	0	=	-	_	-	
- 1	=	(E) BLANK		BLANK	0	13	0			14	0	GEN	(E) LOADS	-	20	
- 1	-	(E) BLANK		BLANK	0	15		0		16	0	-	-	-	1	
- 1	-	(E) BLANK		BLANK	0	17			0	18	0	-	-	-	1	
- 1	-	(E) BLANK		BLANK	0	19	0			20	0	GEN	(E) LOADS	-	20	
- 1	-	(E) BLANK		BLANK	0	21		0		22	0	-	-	-	_	
- 1	-	(E) BLANK		BLANK	0	23			0	24	0	BLANK	(E) BLANK	-	_	
20 1	-	(E) LOADS		GEN	0	25	0			26	0	BLANK	(E) BLANK		-	
20 1	=	(E) LOADS		-	0	27		0		28	0	BLANK	(E) BLANK	-	_	
20 1	-	(E) LOADS		_	0	29			0	30	0	BLANK	(E) BLANK	-	-	
20 1	-	(E) LOADS		GEN	0	31	0			32	0	BLANK	(E) BLANK	-	_	
15 1	-	(E) LOADS		-	0	33		0		34	0	GEN	(E) LOADS	-	20	
15 1	-	(E) LOADS		-	0	35			0	36	0	GEN	(E) LOADS	-	20	
200 3	-	(E) LOADS		GEN	0	37	0			38	0	GEN	(E) LOADS	-	150	
-	-	-		-	0	39		0		40	0	_	-	-	-	
-	-	-		-	0	41			0	42	0	-	-	-		
ALL (CONNECTED	KVA	MAX AMPS		* PHA	ASE TO	TALS	VA		AMP	S			BUS TOTALS	KVA	
TOTA	AL CONNECTED	89.05	247.4		* A-N			32414	4.0	270.	.1			CONNECTED	89.05	
TOTA	AL DEMAND	89.05	247.4		* B-N			30098	3.0	250.				DEMAND	89.05	
TOTA	AL DESIGN	89.05	247.4		* C-N			26542	2.0	221.	.2			DESIGN	89.05	

(E) PANEL "A LOCATION: I FED FROM:	ELECTRICAL R	ООМ		OC DEVICE TYPE: BREAKER DEVICE FAMILY: BOLT ON					SURE: NE ING: SUR GE: 208/1	RFACE): 200 MCB 3-PHASE 4-WIRE	CONTINUOUS(A): 2 BUS SC RATING(A) 350 FAULT CURRENT(A):	
OC N MPS P	OTES	DESCRIPTION		DEMAND CODE	VA	СКТ	PHASE A	LOA B	DS VA C	СКТ	VA	DEMAND CODE	DESCRIPTION	NOTES	OC AMPS F
20 1 -		(E) LOADS		GEN	0	1	0			2	0	GEN	(E) LOADS	-	20 1
20 1 -		(E) LOADS		GEN	0	3		0		4	0	GEN	(E) LOADS	-	20 1
20 1 -		(E) LOADS		GEN	0	5			0	6	0	GEN	(E) LOADS	_	20 1
20 1 -		(E) LOADS		GEN	0	7	0			8	0	GEN	(E) LOADS	_	20 1
20 1 -		(E) LOADS		GEN	0	9		0		10	0	GEN	(E) LOADS	_	20 1
20 1 -		(E) LOADS		GEN	0	11			0	12	0	GEN	(E) LOADS	_	20 1
20 1 -		(E) LOADS		GEN	0	13	0			14	0	GEN	(E) LOADS	-	20 1
20 1 -		(E) LOADS		GEN	0	15		0		16	0	GEN	(E) LOADS	-	20 1
20 1 -		(E) LOADS		GEN	0	17			0	18	0	GEN	(E) LOADS	-	20 1
20 1 -		(E) LOADS		GEN	0	19	0			20	0	GEN	(E) LOADS	-	20 1
20 1 -		(E) LOADS		GEN	0	21		0		22	0	GEN	(E) LOADS	-	20 1
20 1 -		(E) LOADS		GEN	0	23			0	24	0	GEN	(E) LOADS	-	20 1
20 1 -		(E) LOADS		GEN	0	25	0			26	0	GEN	(E) LOADS		20 1
20 1 -		(E) LOADS		GEN	0	27		0		28	0	GEN	(E) LOADS	-	20 1
20 1 -		(E) LOADS		GEN	0	29			0	30	0	GEN	(E) LOADS	-	20 1
20 1 -		(E) LOADS		GEN	0	31	0			32	0	GEN	(E) LOADS	-	20 1
20 1 -		(E) LOADS		GEN	0	33		0		34	0	GEN	(E) LOADS	-	20 1
30 1 -		(E) LOADS		GEN	0	35			0	36	0	GEN	(E) LOADS	-	20 1
30 1 -		(E) LOADS		GEN	0	37	0			38	0	GEN	(E) LOADS	_	20 1
30 1 -		(E) LOADS		GEN	0	39		0		40	0	GEN	(E) LOADS	_	20 1
20 1 -		(E) LOADS		GEN	0	41			0	42	0	GEN	(E) LOADS	-	20 1
ALL CON TOTAL C TOTAL D TOTAL D	ONNECTED EMAND	KVA	MAX AMPS	•	* PH/ * A-N * B-N * C-N		TALS	VA		AMF	rs	•		BUS TOTALS CONNECTED DEMAND DESIGN	KVA

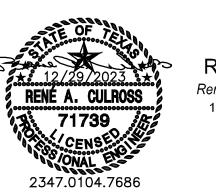

MEP Consultant
Rene' A. Culross
Rene' A. Culross, P.E., PLLC
1820 Hunting Green Drive
Fort Worth, TX 76134
817-798-6642
raculross@gmail.com
F-12230

ARCHITECTURE SCOTT MARTSOLF - ARCHITECT

815 Daggett Avenue Fort Worth, Texas 76104

Phone: (817) 820-0005

ST. JUDE CATHOLIC CHURCH

PARISH HALL
REMODEL &
CONNECTOR
BUILDING

500 E DALLAS ST. MANSFIELD, TX 76063

12/29/23 ADDENDUM #1	

Drawing Title:	
EXISTING PANE SCHED	- : ::-
Project No.	Date:
2307	12/29/2023
	Sheet No.
	E6.1

	C" DN: PANTRY DM: UTILITY		E TYPE: BRE AMILY: BOLT		<u>, </u>	1	MOUNT	SURE: NE ING: SUF GE: 208/	RFACE		•): 400 MCB 3-PHASE 4-WIRE	CONTINUOUS(A): 40 BUS SC RATING(A) 3500 FAULT CURRENT(A):	
OC AMPS P	NOTES	DESCRIPTION	DEMAND CODE	VA	СКТ	PHASE A	LOAI B	OS VA C	СКТ	VA	DEMAND CODE	DESCRIPTION	NOTES	OC AMPS
20 1	-	INTERIOR LIGHTING	LTG	1077	1	2914			2	1837	REC	KITCHEN EQUIPMENT - 2/	4 -	20 1
20 1	-	INTERIOR LIGHTING	LTG	750	3		2577		4	1827	REC	KITCHEN EQUIPMENT - 28	3 -	20 1
20 1	-	INTERIOR RECEPTALCES	REC	900	5			2424	6	1524	REC	KITCHEN EQUIPMENT - K		20 1
20 1	-	INTERIOR RECEPTACLES	REC	360	7	2160			8	1800	REC	KITCHEN EQUIPMENT - K		20 1
30 2	-	KITCHEN EQUIPMENT - K10	REC	5034	9		4125		10	1608	REC	KITCHEN EQUIPMENT - K		20 1
-	-		-	-	11			3165	12	648	REC	KITCHEN EQUIPMENT - K		20 1
20 1	-	KITCHEN EQUIPMENT - K11A	REC	1440	13	2088	0040		14	648	REC	KITCHEN EQUIPMENT - K		20 1
30 2	-	KITCHEN EQUIPMENT - K11B	REC	4992	15		3648	0040	16	1152	REC	KITCHEN EQUIPMENT - K		20 1
-	-	-	-	4000	17	0000		3648	18	1152	REC	KITCHEN EQUIPMENT - K		20 1
20 1 20 1	-	KITCHEN EQUIPMENT - K19 KITCHEN EQUIPMENT - E1A	REC	1080	19	2080	1546		20	1000	REC	KITCHEN EQUIPMENT - 17		20 1
20 1	_	KITCHEN EQUIPMENT - E1A	REC REC	1200 1200	21 23		1546	2700	22 24	346 1500	REC REC	KITCHEN EQUIPMENT - 18 KITCHEN EQUIPMENT - K		15 1 20 1
20 1	-	KITCHEN EQUIPMENT - E1C	REC	1200	25	4032		2700	26	8496	COOL	RTU-PH-1	15 -	40 3
20 1	-	KITCHEN EQUIPMENT - E1D	REC	1200	27	4032	4032		28	-	-	_		1 -0 3
60 2	<u>-</u>	RTU-PH-2	COOL	14112	29		7032	7536	30	_	<u>-</u>		-	
-	_	-	-	_	31	7536		7000	32	11232	COOL	RTU-PH-3	<u>-</u>	50 3
_	_	_	_	_	33	7000	7536		34	-		-	_	_
50 3	<u>-</u>	RTU-PH-4	COOL	11232	35		1000	7488	36	_	_	_	_	_
-	_	_	-	-	37	4176		, , , , ,	38	1260	GEN	KEF-PH-1	_	20 2
_	_	_	_	_	39		4176		40	-		-		
20 1	_	IWH-HP-1	GEN	87	41			3831	42	_	_	_	_	_
20 1	<u>-</u>	KSF-PH-1	MTR	600	43	2100			44	3000	GEN	UH-PH-1	_	20 2
20 1	<u>-</u>	FLOOR RECEPTACLE	REC	1200	45		2700		46	_	_	_	_	_
20 1	<u>-</u>	FLOOR RECEPTACLE	REC	1200	47			2200	48	1000	REC	KITCHEN EQUIPMENT - E	1E -	20 1
20 1	-	INTERIOR RECEPTACLE	REC	1200	49	2200			50	1000	REC	KITCHEN EQUIPMENT - E	1F _	20 1
20 1	-	INTERIOR RECEPTACLE	REC	1200	51		2200		52	1000	REC	KITCHEN EQUIPMENT - E	1G _	20 1
20 1	-	INTERIOR RECEPTACLE	REC	1200	53			2200	54	1000	REC	KITCHEN EQUIPMENT - E	1H -	20 1
20 1	-	EXTERIOR RECEPTACLE	REC	180	55	1180			56	1000	REC	KITCHEN EQUIPMENT - E	11 -	20 1
20 1	-	EXTERIOR RECEPRACLE	REC	180	57		680		58	500	LTG	EXTERIOR LTG CONTACT	OR -	20 1
20 1	-	EXTERIOR RECEPTACLES	REC	360	59			860	60	500	LTG	EXTERIOR LIGHTING	-	20 1
20 1	-	EXTERIOR RECEPTACLE	REC	180	61	1380			62	1200	REC	KITCHEN EQUIP - E1J & E		20 1
20 1	-	KITCHEN EQUIP - E1S & E1T	REC	1200	63		2400		64	1200	REC	KITCHEN EQUIP - E1L & E		20 1
20 1	-	KITCHEN EQUIPMENT E1U	REC	1200	65			2400	66	1200	REC	KITCHEN EQUIP - E1N & E		20 1
20 1	-	KITCHEN EQUIPMENT E1V	REC	1200	67	2400			68	1200	REC	KITCHEN EQUIP - E1Q & E	E1R -	20 1
20 1	-	KITCHEN EQUIPMENT E1W	REC	1200	69		1200	^	70	0	SPR	SPARE	-	20 1
20 1	-	SPARE	SPR	0	71	0		0	72	0	SPR	SPARE	-	20 1
20 1	-	SPARE	SPR	0	73	0	0		74	0	SPR	SPARE	-	20 1
20 1 20 1	-	SPARE SPARE	SPR SPR	0 0	75 77		0	0	76 78	0	SPR	SPARE	-	20 1
20 1	_	SPARE	SPR	0	79	0		U		0	SPR SPR	SPARE SPARE	-	20 1 20 1
20 1	-	SPARE	SPR	0	81	U	0		80 82	0	SPR	SPARE SPARE	-	20 1
20 1	<u>-</u>	SPARE	SPR	0	83		U	0	84	0	SPR	SPARE	_	20 1
			31 1								SFK			
	CONNECTED	KVA MAX AMPS			ASE TOT	ALS	VA		AMP				US TOTALS	KVA
	AL CONNECTED	88.33 245.4		* A-N			34346		286.					108.62
	AL DEMAND	88.33 245.4		* B-N			36820		306.				EMAND (125% LTG)	3.53
TOTA	AL DESIGN	88.33 245.4		* C-N			38542	U	321.	2			,	47.12
													` ,	37.68 88.33
														88.33
													LOIDIN	

PANELBOARD NOTES ONLY

- 1. EXISTING CIRCUIT BREAKER AND LOAD(S) TO REMAIN AS IS.
- DISCONNECT AND REMOVE EXISTING "BLANK" FILLER TO ALLOW NEW CIRCUIT BREAKER AS INDICATED.
- 3. PROVIDE A NEW CIRCUIT BREAKER AS INDICATED. MATCH EXISTING MANUFACTURER AND AIC RATING.
- 4. PROVIDE AN UPDATE PANELBOARD SCHEDULE.

MARK	TYPE OF LUMINAIRE	MANUFACTURE / CATALOG NUMBER	QTY-TYPE OF LAMP	MAXIMUM INPUT WATTS	INPUT VOLTAGE	ALLOCATED FIXTURE LOAD(VA)	MOUNTING	NOTES
A	LED PENDANT LIGHT	WAC LIGHTING # PD-42918-BK	LED (2400 LUMENS)	41	120	41	PENDANT	1
В	LED PENDANT LIGHT	WAC LIGHTING # PD-72718-BK	LED (2450 LUMENS)	33.5	120	33.5	PENDANT	1
С	6" APERATURE DOWNLIGHT	LITHONIA LIGHTING # LDN6 30 20 L06 AR LSS 120	LED	26	120	26	RECESSED	1
CE	6" APERATURE DOWNLIGHT	LITHONIA LIGHTING # LDN6 30 20 L06 AR LSS 120 EL	LED	26	120	26	RECESSED	1,2
D	6" APERATURE DOWNLIGHT	LITHONIA LIGHTING # LDN6 30 20 L06 AR LSS 120	LED	26	120	26	RECESSED	1
DE	6" APERATURE DOWNLIGHT	LITHONIA LIGHTING # LDN6 30 20 L06 AR LSS 120 EL	LED	26	120	26	RECESSED	1,2
G	2 x 2 FLAT PANEL LIGHT	LITHONIA LIGHTING # EPANL2X2 3400LM 80CRI 35K ZT 120	LED	31	120	31	RECESSED	1
GE	2 x 2 FLAT PANEL LIGHT	LITHONIA LIGHTING # EPANL2X2 3400LM 80CRI 35K E10WCP ZT 120	LED	31	120	31	RECESSED	1,2
Н	VANITY LIGHT	WAC LIGHTING # WS-77624-35-BK	LED	20.5	120	20.5	WALL	1
J	4'-0" LED STRIPLIGHT	LITHONIA LIGHTING # ZLIN L48 ASR 3000LM ASR 120 30K 80 CRI WH HC36M12	LED	25	120	25	SUSPENDED	1
JE	4'-0" LED STRIPLIGHT	LITHONIA LIGHTING # ZLIN L48 ASR 3000LM ASR 120 30K 80 CRI E10WLCP WH HC36M12	LED	25	120	25	SUSPENDED	1,2
K 1	WALL PACK	PAC LIGHTS # FWPR/2-025-30	LED	25	120	25	WALL	1
L	LIGHT BLOLLARD	MATCH EXISTING BOLLARDS	LED	20	120	20	GRADE	1
М	ACCENT LIGHT	LITHONIA LIGHTING # DSXF1-LED-P1-WFL-MVOLT-THK	LED	21	120	21	GRADE	1
N	6" APERATURE DOWNLIGHT WITH GLASS LENS	CALIBER PLUS # SERIES 5LBVG W/GDW DECO GLASS LENS	LED	26	120	26	RECESSED	1
P 1	4'-0" TRACK	JUNO TRACK # R4BL TRAC-MASTER LIMITER SWITCH # TCLF11BL TRACK HEAD # T259L G2 35K 80CRI PDIM BL	LED	60W PER HEAD (5 TOTAL)	120	300	SURFACE	1,3,4
(RR)	EXISTING LIGHT FIXTURE	EXISTING RELOCATED LIGHT FIXTURE			120		ĜŔADÊ	
(NL)	EXISTING RELOCATED LIGHT FIXTURE	EXISTING RELOCATED LIGHT FIXTURE	-	-	120	-	GRADE	1
X1	EXIT SIGN W/EMERGENCY BUG-EYES	LITHONIA LIGHTING # LHQM LED R M6	LED	4.3	120	4.3	UNIVERSAL	1
EBU	EMERGENCY BATTERY UNIT	COOPER LIGHTING SURE-LITE # AEL2-31-BK	LED	2.2	120	2.2	WALL	1

NO	DESCRIPTION	N UNIT SERVES			LOAD			DISCONNE	CT AT UNIT	C	NOTES	
NO.	NO. DESCRIPTION		MCA	МОСР	kW OR HP	FLA	VOLTS/PH	TYPE	MOUNTING	NUMBER	WIRE SIZE	NOTES
(RTU-PH-1)	ROOF TOP UNIT - PH - 1	KITCHEN AREA	29.5	40A	-	-	208 / 3	BY DIVISION 23	BY DIVISION 23	C-26,28,30	1"C - 3#8, 1#10G	1
(RTU-PH-2)	ROOF TOP UNIT - PH - 2	EXIST. FACILITY	49.0	60A	-	-	208 / 3	BY DIVISION 23	BY DIVISION 23	C-29,31,33	1-1/4"C - 3#4, 1#10G	1
(RTU-PH-3)	ROOF TOP UNIT - PH - 3	CONNECTOR	39.0	50A	-	-	208 / 3	BY DIVISION 23	BY DIVISION 23	C-32,34,36	1"C - 3#6, 1#10G	1
(RTU-PH-4)	ROOF TOP UNIT - PH - 4	CONNECTOR	39.0	50A	-	-	208 / 3	BY DIVISION 23	BY DIVISION 23	C-35,37,39	1"C - 3#6, 1#10G	1
(UH-PH-1)	UNIT HEATER - PH - 1	RISER ROOM	14.5	20A	-	-	208 / 1	30A/NF/NEMA 1	ADJACENT TO UNIT	C-44,46	3/4"C - 3#12, 1#12G	1
(EF-PH-1)	EXHAUST FAN - PH - 1	EXIST TOILETS	=	20A	0.3 HP	-	120 / 1	BY DIVISION 23	BY DIVISION 23	B1-5	3/4"C - 2#12, 1#12G	1
(EF-PH-2)	EXHAUST FAN - PH - 2	TOILETS	=	20A	85W	-	120 / 1	BY DIVISION 23	BY DIVISION 23	C-3	3/4"C - 2#12, 1#12G	1
(EF-PH-3)	EXHAUST FAN - PH - 3	CRAWL SPACE	-	20A	0.17 HP	-	120 / 1	BY DIVISION 23	BY DIVISION 23	B1-5	3/4"C - 2#12, 1#12G	1
(EF-PH-4)	EXHAUST FAN - PH - 4	CRAWL SPACE	-	20A	0.17 HP	-	120 / 1	BY DIVISION 23	BY DIVISION 23	B1-5	3/4"C - 2#12, 1#12G	1
(KEF-PH-1)	KITCHEN EXHAUST FAN - PH - 1	KITCHEN HOOD	-	20A	0.75 HP	-	208 / 3	BY DIVISION 23	BY DIVISION 23	C-38,40,42	3/4"C - 3#12, 1#12G	1
(KSF-PH-1)	KITCHEN SUPPLY FAN - PH - 1	KITCHEN HOOD	-	20A	0.33 HP	-	120 / 1	BY DIVISION 23	BY DIVISION 23	C-43	3/4"C - 2#12, 1#12G	1
		+ +		1	+ +				†	t	ł	

120 / 1

208 / 1

208 / 1

LOCKABLE C.B.

LOCKABLE C.B.

LOCKABLE C.B.

IN PANELBOARD

IN PANELBOARD

IN PANELBOARD

MECHANICAL EQUIPMENT / ELECTRICAL SCHEDULE BY SYMBOL "#"

GENERAL NOTES APPLY TO ALL:

(IWH-1) INSTANTANEOUS WATER HTR - 1

(IWH-2) INSTANTANEOUS WATER HTR - 2

WH-PH-1 WATER HEATER - HP - 1

VERIFY MOUNTING REQUIREMENTS WITH EQUIPMENT INSTALLER.
VERIFY ACTUAL EQUIPMENT LOADS AND CONNECTION REQUIREMENTS WITH EQUIPMENT BEING INSTALLED.


20A 3 KW

20A 3 KW

20A 3 KW

2 BE: 1/E0.3 EMERGENCY BALLAST/DRIVER SWITCHING DETAIL FOR ADDITIONAL INFORMATION,
3. PROVIDE A 300 WATT LIMITER SWITCH. ONE (1) PER TRACK.
4. COORDINATE EXACT LOCATION WITH THE ARCHITECT RCP PLAN PRIOR TO INSTALLATION.

1. WIRE SIZED IS BASED ON NEC 310.16 75 DEGREE WIRE AND COPPER.

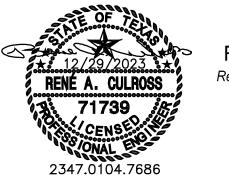

C-41

B1-2,4

3/4"C - 2#12, 1#12G

B1-6,8 3/4"C - 2#12, 1#12G 1

3/4"C - 2#12, 1#12G 1

MEP Consultant Rene' A. Culross Rene' A. Culross, P.E., PLLC 1820 Hunting Green Drive Fort Worth, TX 76134 817-798-6642 raculross@gmail.com F-12230

ARCHITECTURE SCOTT MARTSOLF - ARCHITECT

815 Daggett Avenue Fort Worth, Texas 76104 Phone: (817) 820-0005

> ST. JUDE CATHOLIC CHURCH

PARISH HALL REMODEL & CONNECTOR BUILDING

500 E DALLAS ST. MANSFIELD, TX 76063

12/29/23 ADDENDUM #1	

Drawing Title:						
PANELBOARD & LIGHT FIXTURE SCHEDULES						
Project No.	Date:					
2307	12/29/2023					
	Sheet No.					
	E6.2					

	ELECTRIC INSTANTANEOUS WATER HEATER SCHEDULE																	
MARK	SERVICE	MIN FLOW RATE	MAX FLOW	WATER	INPUT WATER HOLDING		RISE INPUT	I INPLIT	TEMP RISE INPUT		INPLIT I		ELECTRICAL DATA				MANUFACTURER/	REMARKS
IWH	SERVICE	(GPM)	RATE (GPM)	(DEG-F)	(KWH)	(KWH) CAP (GAL)		МОСР	VOLTS	РН	MODEL SERIES	KEWAKKO						
PH-2	DOMESTIC HOT WATER	0.3	2.5	40	3.0	0.3	15	20	208	1	EEMAXLAVADVANTAGE	1,2,3						
PH-3	DOMESTIC HOT WATER	0.3	2.5	40	3.0	0.3	15	20	208	1	EEMAXLAVADVANTAGE	1,2,3						

REMARKS:

- 1. PROVIDE WITH INTEGRAL THERMOSTATIC MIXING VALVE, FLOW CONTROL VALVE, AND DIGITAL TEMPERATURE DISPLAY
- PROVIDE WITH LOCKABLE CIRCUIT BREAKER AT ELECTRICAL PANEL.
 SYSTEM SHALL BE CAPABLE OF VARIABLE FLOW FOR MULTIPLE FIXTURE USE.

	NATURAL GAS-FIRED INSTANTANEOUS WATER HEATER											
MARK	SERVICE	MIN FLOW RATE	MAX FLOW	WATER TEMP RISE	MAX GAS INPUT	MIN GAS PERFORMAN	WATER HOLDING		CTRICAL D	ATA	MANUFACTURER/	REMARKS
IWH-	OLIVIOL .	(GPM)	RATE (GPM)	(DEG-F)	(MBH)		CAP (GAL)		VOLTS	PH	MODEL SERIES	TLIII/TTTO
PH-1	DOMESTIC HOT WATER	0.5	4.8	60	120	15	0.3	86	120	1	AO SMITH AT1-140H-N	1,2,3

REMARKS:

- 1. DIRECT VENT/SEALED COMBUSTION CONNECTIONS (DUCTED COMBUSTION). SIZE VENTS IN ACCORDANCE WITH THE MANUFACTURERS RECOMMENDATIONS.
- 2. PROVIDE SYSTEM CONTROLLER. SYSTEM CONTROLLER SHALL BE CAPABLE OF ENERGIZING WATER HEATER AS REQUIRED FOR WATER FLOW DEMAND.
- 3. PROVIDE WITH PVC VENT TERMINATION KIT (LoNox CONDENSING)

	PLUMBING FIX	TUF	RE S	CHE	EDUL	<u>-E</u>	
MARK	DESCRIPTION	RO W	UGH IN	(MINIMUI	M) HW	MANUFACTURER AND MODEL NUMBER	ADA /TAS
WC1	WATERCLOSET, FLOOR MOUNT, FLUSHOMETER VALVE TYPE, RATED FOR HIGH EFFICIENCY FLUSHING ACTION (1.28 GPF), TOP SPUD, ELONGATED, SIPHON ACTION JETTED BOWL, VITREOUS CHINA, WHITE, ASME A112.19.2, 2" FULLY GLAZED TRAPWAY	4"	2"	-	_	AMERICAN STANDA 2234.001 OR AS SELECTED BY OWNER (VIA ARCHITECT)	
	FLUSHOMETER VALVE, HIGH EFFICIENCY (1.28 GPF), MANUAL FLUSH, 1-1/2" TOP SPUD, SPUD COUPLING AND FLANGE, CHROME PLATED ANGLE STOP WITH STOP CAP, VACUUM BREAKER FLUSH CONNECTION, CAST WALL FLANGE WITH SET SCREW, ANSI/ASME 112.19.6	_	_	1 1/2"	_	SLOAN, CROWN 111-1.28 OPTIMA SMO; KOHLER, K-10673; ZURN, ZER6200PEV-CPM	
	SEAT, EXTRA HEAVY WEIGHT, POSTURE MOLDED SOLID PLASTIC, ELONGATED, OPEN FRONT, LESS COVER, EXTERNAL CHECK HINGES, STAINLESS STEEL HINGE POSTS, WHITE	_	_	_	_	CHURCH 9500C; BEMIS, 1655C; OLSONITE, 95/SS	
WC2	WATERCLOSET, FLOOR MOUNT, FLUSHOMETER VALVE TYPE, RATED FOR HIGH EFFICIENCY FLUSHING ACTION (1.28 GPF), TOP SPUD, ELONGATED, SIPHON ACTION JETTED BOWL, VITREOUS CHINA, WHITE, ASME A112.19.2, 2" FULLY GLAZED TRAPWAY	4"	2"	_	_	AMERICAN STANDARD 3043.001 OR AS SELECTED BY OWNER (VIA ARCHITECT)	X
	FLUSHOMETER VALVE, HIGH EFFICIENCY (1.28 GPF), MANUAL FLUSH, 1–1/2" TOP SPUD, SPUD COUPLING AND FLANGE, CHROME PLATED ANGLE STOP WITH STOP CAP, VACUUM BREAKER FLUSH CONNECTION, CAST WALL FLANGE WITH SET SCREW, ANSI/ASME 112.19.6	_	_	1 1/2"	_	SLOAN, CROWN 111-1.28 OPTIMA SMO; KOHLER, K-10673; ZURN, ZER6200PEV-CPM	
	SEAT, EXTRA HEAVY WEIGHT, POSTURE MOLDED SOLID PLASTIC, ELONGATED, OPEN FRONT, LESS COVER, EXTERNAL CHECK HINGES, STAINLESS STEEL HINGE POSTS, WHITE	_	_	_	_	CHURCH 9500C; BEMIS, 1655C; OLSONITE, 95/SS	
U1	URINAL, WALL MOUNT, VITREOUS CHINA, 14" EXTENDED FLUSHING RIM, SIPHON JET ACTION, 3/4" INLET SPUD, INLET AND OUTLET SPUDS AND HANGERS, 1.0 GPF, ASME/ANSI A112.19.2, STANDARD HEIGHT RIM	2"	2"	_	_	AMERICAN STANDARD,6541.132; KOHLER,K-5016-ET; CRANE,7309; ZURN, Z5730	
	FLUSHOMETER VALVE, EXPOSED DIAPHRAGM—TYPE, CHROME PLATED, 3/4" TOP SPUD, SPUD COUPLING AND FLANGE, OSCILLATING NON—HOLD OPEN HANDLE, CHROME PLATED ANGLE STOP WITH STOP CAP, VACUUM BREAKER FLUSH CONNECTION, CAST WALL FLANGE WITH SET SCREW, ANSI/ASME 112.19.6	_	_	3/4"	_	SLOAN REGAL MODEL 186-1.0YBYC; ZURN, Z6003-WS1; GEBERIT, 116.700.21.1	
U2	FIXTURE CARRIER, HANGER AND BEARING PLATES, ADJ. SUPPORTING RODS, UPRIGHTS, WELDED FEET URINAL, WALL MOUNT, VITREOUS CHINA, 14" EXTENDED FLUSHING RIM, SIPHON JET ACTION, 3/4" INLET	_ 2"	_ 2"			JOSAM, SERIES 17560-UR; WATTS, CA-321; ZURN, Z1222; OR JR SMITH, 0632 AMERICAN STANDARD,6541.132; KOHLER,K-5016-ET; CRANE,7309; ZURN, Z5730	X
-	SPUD, INLET AND OUTLET SPUDS AND HANGERS, 1.0 GPF, ASME/ANSI A112.19.2, ADA HEIGHT RIM			3/4"		SLOAN REGAL MODEL 186-1.0YBYC; ZURN, Z6003-WS1; GEBERIT, 116.700.21.1	^
	FLUSHOMETER VALVE, EXPOSED DIAPHRAGM—TYPE, CHROME PLATED, 3/4" TOP SPUD, SPUD COUPLING AND FLANGE, OSCILLATING NON—HOLD OPEN HANDLE, CHROME PLATED ANGLE STOP WITH STOP CAP, VACUUM BREAKER FLUSH CONNECTION, CAST WALL FLANGE WITH SET SCREW, ANSI/ASME 112.19.6	_	_	3/4	_	SLOAN REGAL MODEL 100-1.01BTC; ZURN, ZOUUS-WST; GEBERT, 110.700.21.1	
L1	LAVATORY, 23"x18" RECTANGULAR SELF—RIMMING BASIN WITH FAUCET LEDGE, VITREOUS CHINA, FRONT OVERFLOW, ANSI A112.19.2		1 1/2	· –		JOSAN, SERIES 17560-UR; WATTS, CA-321; ZURM, ZT222; OR JR SMITH, 0632 KOHLER 2337-4 OR AS SELECTED BY OWNER (VIA ARCHITECT)	X
_>	FAUCET, DECK MOUNT, CHROME PLATED BRASS, 4" INTEGRAL RIGID SPOUT, TWO-HANDLE, 1/4 TURN 4" WRIST BLADE HANDLES, 4" CENTERS, NSF 61 COMPLIANT, ANSI A112.18.1M, 0.5 GPM MAX. FLOW RATE	-	-	1/2"	1/2"	AMERICAN STANDARD 7500.175 OR AS SELECTED BY OWNER	
>	SUPPLY AND STOPS, LOOSE KEY, CHROME PLATED BRASS VALVES AND CHROME PLATED COPPER RISERS P-TRAP, CHROME PLATED CAST BRASS BODY WITH CLEANOUT, SEAMLESS WALL BEND, 17 GA.	_	_	_	_	MCGUIRE, H2165CCLK; T&S BRASS, B-1305; OR BRASSCRAFT, OCR1912A MCGUIRE, 8902; BRASSCRAFT, 507; OR EQUAL IN T&S BRASS	1
}	OFFSET TAILPIECE AND STRAINER, CHROME PLATED CAST BRASS THERMOSTATIC MIXING VALVE, POINT OF USE, REPLACEABLE CARTRIDGE CONSTRUCTION, 0.5 GPM MINIMUM FLOW, 10 PSIG LOSS AT 0.7 GPM, INTEGRAL INLET CHECK VALVES AND STRAINER. ASSE 1070			1/2"	1/2"	MCGUIRE, 155WC; OR EQUAL IN T&S BRASS; OR BRASSCRAFT ARMSTRONG, RADA MODEL 110 OR EQUAL	
HS1	FAUCET, DECK MOUNT, CHROME PLATED BRASS, 6" INTEGRAL SPOUT, TWO-HANDLE, 1/4 TURN 4" WRIST BLADE HANDLES, 4" CENTERS, NSF 61 COMPLIANT, ANSI A112.18.1M, 0.5 GPM MAX. FLOW RATE		1/2	1/2"	1/2"	ADVANCE TABOO, MONEL 7-PS-25 OR AS SELECTED BY OWNER (VIA ARCHITECT) ADVANCE TABCO FACTORY STANDARD OR AS SELECTED BY OWNER (VIA ARCHITECT)	
	SUPPLY AND STOPS, LOOSE KEY, CHROME PLATED BRASS VALVES AND CHROME PLATED COPPER RISERS P-TRAP, CHROME PLATED CAST BRASS BODY WITH CLEANOUT, SEAMLESS WALL BEND, 17 GA.	_	<u> </u>		_	MCGUIRE, H2165CCLK; T&S BRASS, B-1305; OR BRASSCRAFT, OCR1912A MCGUIRE, 8902; BRASSCRAFT, 507; OR EQUAL IN T&S BRASS	
	OFFSET TAILPIECE AND STRAINER, CHROME PLATED CAST BRASS THERMOSTATIC MIXING VALVE, POINT OF USE, REPLACEABLE CARTRIDGE CONSTRUCTION, 0.5 GPM MINIMUM FLOW, 10 PSIG LOSS AT 0.7 GPM, INTEGRAL INLET CHECK VALVES AND STRAINER. ASSE 1070	_ _	-	1/2"	- 1/2"	MCGUIRE, 155WC; OR EQUAL IN T&S BRASS; OR BRASSCRAFT ARMSTRONG, RADA MODEL 110 OR EQUAL	-
MSB	MOP SINK BASIN, ONE PIECE—PRECAST TERRAZZO 24"x24"x12" (1 1/4" WALL THICKNESS WITH MINIMUM 9.75" INSIDE DEPTH) 6" DROP FRONT, STAINLESS STEEL EDGE CAPS ON ALL SIDES, STAINLESS STEEL WALL GUARDS, CAST BRASS DRAIN WITH STAINLESS STEEL STRAINER	3"	2"	_	_	FIAT MODEL TSB-3000; STERN WILLIAMS HL-1810; FLORESTONE MODEL 92	
EWC1	FAUCET, EXPOSED YOKE, WALL MOUNTED UTILITY FAUCET, VACUUM BREAKER, 6"THREADED SPOUT TWO STATION WATER COOLER, INDOOR BI-LEVEL WALL MOUNTED, SELF CONTAINED ELECTRIC	- 2"	- 1 1/2	3/4"	3/4"	MOEN, 8124;CHICAGO,540-LD897SWXFCP; DELTA, 28T2383; T&S BRASS, B-0665 HALSEY TAYLOR HAC8BLPV-WF OR AS SELECTED BY OWNER (VIA ARCHITECT)	V
2,701	REFRIGERATION, STAINLESS STEEL BASIN AND CABINET WITH ANTI—SPLASH RIDGE, INTEGRAL DRAIN STRAINER, NON—SQUIRT BUBBLER, PUSH BAR ACTIVATION ON FRONT AND SIDES OF WATER COOLER. REFRIGERATION SYSTEM SERVING BOTH BI—LEVELS TO INCLUDE HIGH EFFICIENCY COMPRESSOR, R—134A, FULLY INSULATED STAINLESS STEEL TANK, 8 GPH WITH 50°F SUPPLY TEMPERATURE AND 80°F AMBIENT; FREEZE PROOF WITH ADA APRON; 115VOLT. ANSI 117.1, NFS/ANSI 61, ARI STANDARD 1010	2	1 1/2			THESE THOUSEN THOUSEN	X
	SERVICE STOP WITH DIELECTRIC COUPLING P-TRAP, PVC, WHITE		_	1/2"	_	REFER TO MANUFACTURER FOR REQUIREMENTS DEARBORN BRASS, A9701BG; KEYSAN MOEM9100; OR EQUAL	
WMB	FIXTURE CARRIER, STEEL TOP AND BOTTOM PLATES W/ ADJ. HOLES, CHROME PLATED CAP NUTS/WASHERS WASHING MACHINE CONNECTION BOX, RECESSED WHITE POWDER COATED, CENTER DRAIN		1 1/2	_ " 1/2"	1/2"	JOSAM SERIES 17905; OR EQUAL IN ZURN OR JR SMITH GUY GRAY MODEL WMOB; GUY GRAY FRIB12ABP IN RATED CONSTRUCTION	
FD	FLOOR DRAIN, CAST IRON BODY, ANCHOR FLANGE, WEEPHOLES FOR DOUBLE DRAINAGE, 6" STAINLESS STEEL FLAT STRAINER. ADJUSTABLE DRAIN HEAD W/ MACHINED INTEGRAL BODY THREADS, ASME A112.21.1	_	-	-	-	JOSAM SERIES 30000-A-SS; MIFAB F1000; ZURN Z-415-S6	
FS1	FLOOR SINK, 12"x12"x8", CI BODY, DBL DRAINAGE FLANGE, STAINLESS STEEL DOME STRAINER, 1/2 GRATE, NON—PUNCTURING FLASHING COLLAR, PORCELAIN ENAMEL OR EPOXY COATED INTERIOR	3"	-	_	_	JOSAM SERIES 49320A-3 OR EQUAL IN MIFAB OR ZURN	
HB1 HB2	NON -FREEZE ROOF POST HYDRANT, VACUUM BREAKER, 3/4" MALE NHT OUTLET NON-FREEZE WALL HYDRANT, CONCEALED WALL TYPE WITH CYLINDER LOCK, STAINLESS STEEL BOX AND COVER OR CHROME FINISH ON BRASS CASTINGS, INTEGRAL VACUUM BREAKER,			3/4"		EQUAL TO ZURN Z1388 JOSAM 71350 OR EQUAL IN MIFAB OR ZURN	
RD/OF	ROOF DRAINING LOOSE KEY HANDLE, 1/2" INLET: 3/4" HPT ONTLET ROOF DRAIN, LARGE SUMP, CAST IRON BODY, 12"DIA. CAST IRON OR DUCTILE IRON DOME	_	_	_	_	EQUAL TO ZURN 21500 SERIES	
FCO	STRAINER, ANCHOR FLANGE AND CLAMP, ADJUSTABLE/INTEGRAL GRAVEL STOP; ADJUSTABLE INTERNAL STANDPIPE DAM ON OVERFLOW DRAIN; ASME A112.21.2 FLOOR CLEANOUT, COATED CAST RON BODY, COMBINATION ADJUSTABLE ROUND STAINLESS					JOSAM SERIES 58360; MIFAB C1000-R/S; ZDRNZ-1400	لر
	STEEL COVER AND PLUG TOP ASSEMBLY, GASKET SEAL, ASME 112.36.2					, , , , , , , , , , , , , , , , , , , ,	
WCO GCO	WALL CLEANOUT, CI BODY, RECESSED, THREADED BRASS PLUG, STAINLESS STEEL ACCESS COVER GRADE CLEANOUT, HEAVY DUTY COATED CAST IRON ACCESS BODY WITH ANCHOR FLANGES,	_ _	_	<u> </u>	<u>-</u>	JOSAM SERIES 58890; MIFAB C1460; ZURN Z-1441 JOSAM SERIES 56680-5-26-VP; MIFAB C1300-MF-6; ZURN Z-1474-SG-VP	
DCO	HEAVY DUTY DUCTILE IRON ACCESS COVER WITH VANDAL RESISTANT STAINLESS STEEL SCREWS 2-WAY GRADE CLEANOUT, TWO-RISER CLEANOUT BODY WITH HEAVY DUTY COATED CAST IRON ACCESS BODY WITH ANCHOR FLANGES, HEAVY DUTY DUCTILE IRON ACCESS COVER WITH VANDAL RESISTANT STAINLESS STEEL SCREWS	_	_	-	_	JOSAM SERIES 56680-5-26-VP; MIFAB C1300-MF-6; ZURN Z-1474-SG-VP	
PCO NOTES:	SPIGOT CONNECTION, RAISED HEAD THREADED BRASS PLUG	- NANCE	- NECI	- FCCADY	- FOR ^	JOSAM; MIFAB; ZURN	
2. Al 3. Al	ONTRACTOR SHALL FURNISH AND INSTALL SUPPLIES, STOPS, TRAPS, TAILPIECES AND ALL APPURTE LL ADA ACCESSIBLE SINKS AND LAVATORIES SHALL BE EQUIPPED WITH TRUEBRO #103 UNDERSINM BOVE THE FLOOR P—TRAPS ON LAVS AND SINKS SHALL BE 17 GAUGE, CHROME PLATED BRASS. ONTRACTOR SHALL VERIFY FIXTURE SUPPLIES AND APPURTENANCES FOR EACH FIXTURE PRIOR TO	PROT ACCEF	ECTIVE PTABLE	PIPE C	OVERS ACTURE	WHERE NOT CONCEALED BY MILLWORK.	
5. C0	ONTRACTOR SHALL VERIFY ADA PLUMBING FIXTURES PROVIDED COMPLY WITH HANDICAPPED ACCEST ROVIDE NON—SHRINK GROUT BELOW ALL SHOWER ENCLOSURES AND SHOWER RECEPTORS AS REC ERIFY FIXTURE COLOR, FINISH SELECTIONS, AND STYLE WITH OWNER (VIA ARCHITECT) PRIOR TO O	SIBILITY OMMEN	STANI DED B	DARDS I Y THE I	NCLUDI		



MEP Consultant
Rene' A. Culross
Rene' A. Culross, P.E., PLLC
1820 Hunting Green Drive
Fort Worth, TX 76134
817-798-6642
raculross@gmail.com
F-12230

ARCHITECTURE SCOTT MARTSOLF - ARCHITECT

815 Daggett Avenue Fort Worth, Texas 76104

Phone: (817) 820-0005

ST. JUDE
CATHOLIC
CHURCH
PARISH HALL
REMODEL &
CONNECTOR

500 E DALLAS ST. MANSFIELD, TX 76063

12/29/23 ADDENDUM #1	

PERMIT SET

Drawing Title: PLUMBING SCHEDULES					
Project No.	Date:				
2307	1/12/2024				
	Sheet No.				
	P0.3				